Township N. IV North, Range N. I East (Mich. Tim.)

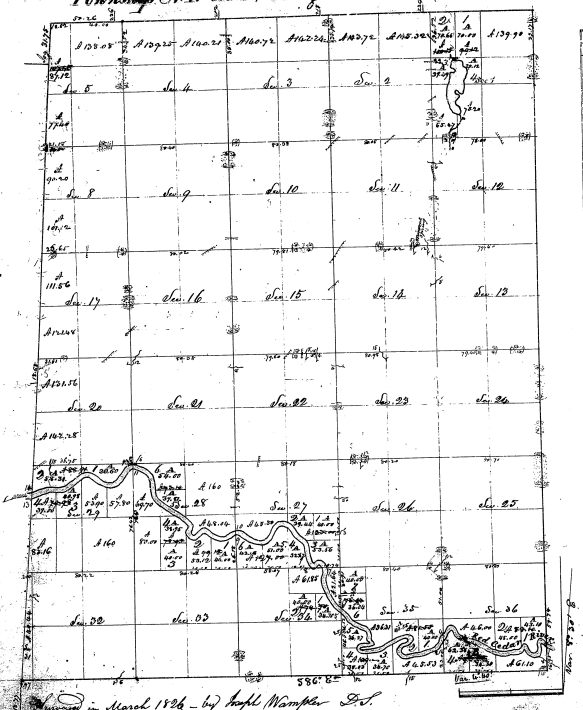

Surveyed in March 1826 - by Joseph Wampler D.S.

Sections	Acres	Rej.
N½ NE¼ 1	139	90
S½ "	80	
E½ NW¼	99	12
W½ "	100	15
E½ SE¼	160	
E½ SW¼	75	92
W½ "	65	47
N½ NE¼ 2	105	32
S½ "	80	
N½ NW¼	143	72
S½ "	80	
S½	320	
N½ NE¼ 3	142	24
S½ "	80	
N½ NW¼	140	72
S½ "	80	
S½	320	
N½ NE¼ 4	140	24
S½ "	80	
N½ NW¼	139	25
S½ "	80	
S½	320	
N½ NE¼ 5	138	08
S½ "	80	
NW¼ "	87	12
SE¼ "	160	
SW¼ "	97	40
E½ 8	320	
NW¼ "	90	20
SW¼ "	101	12
Sec. 9	640	
10	640	
11	640	
12	640	
13	640	
14	640	
15	640	
16	640	
E½ 17	320	
NW¼ "	111	56
SW¼ "	101	48
E½ 20	320	
NW¼ "	131	02
SW¼ "	162	28
Sec. 21	640	
22	640	
23	640	
24	640	
25	640	
26	640	
	14173	10

Sections	Acres	Rej.
N½ 27	320	
N fract. SE¼	103	
S fract. SE¼	45	50
S fract. "	127	—
N½ 28	160	
E½ NW¼ "	73	10
W½ "	69	70
N fr. SE¼ "	48	64
S fr. "	99	12
E½ SW¼ "	73	96
W½ "	80	
S fract. 29	88	91
E½ NE¼ "	87	80
W½ "	50	80
S fract. NW¼ "	97	98
SE¼ "	160	
E½ SW¼ "	80	
W½ "	83	16
fract. 31	40	04
fract. 32	640	
33	640	
N½ fract. 34	91	64
N½ NE¼ "	61	85
S½ "	74	70
NW¼ "	160	
S½ "	320	
W½ 35	160	
E½ NW¼ "	80	
W½ "	76	09
N fr. SE¼ "	58	83
S fr. "	48	53
N fr. SW¼ "	36	81
S fr. "	109	
W½ 36	332	
N fract. SE¼	88	10
S fract. "	61	10
N fract. SW¼ "	46	
S fract. "	98	85
	4987	07
	1412	10
	13574	17

Total