5-29

Township No. IV north, Range No. II west (Mich. Ter.)

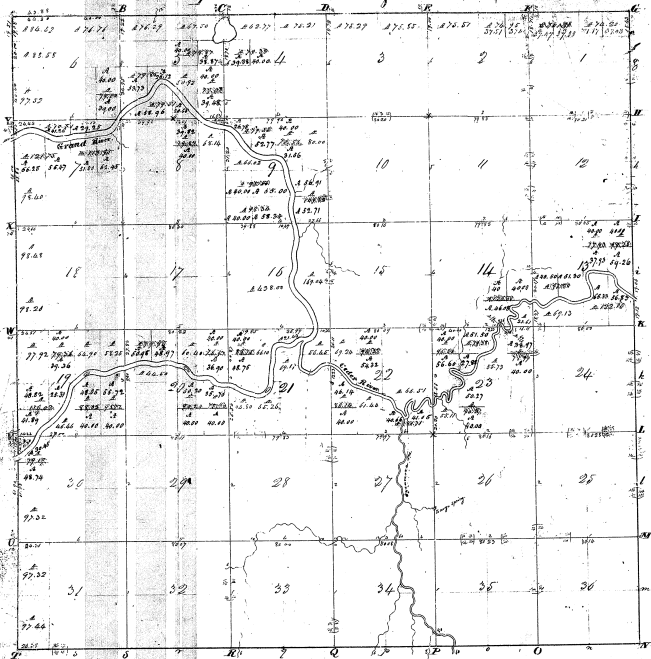

Surveyed in February 1827 by Musgrove Evans

Sec.	32	640							
	33	640							
	34	640							
	35	640							
	36	640							
		3202	00						
		18718	60						
		9816	47						
Total		22735	07						

Nr. N E	1	74	20		Sec.	15	640		
Sec.		80			Ep.	16	169	24	
Nr. N W		74	80		Wp.		438	00	
Sec.		80			Sec.	17	640		
Sec.		320			Sec.	18	320		
Nr. N E	2	74	96		Ex. N W		80		
Sec.		80			Wr.		98	48	
Nr. N W		75	51		Ex. S W		80		
Sec.		80			Wr.		98	20	
Sec.		320			Ep. N E	19	58	25	
Nr. N E	3	75	55		Wp.		64	90	
Sec.		80			Ex. N W		79	36	
Nr. N W		75	29		Wr.		97	92	
Sec.		80			Ep. S E		95	72	
Sec.		320			Wp.		88	05	
Nr. N E	4	75	21		Ep. S W		64	46	
Sec.		80			Wp.		116	02	
Nr. N W		62	77		Ep. N E	20	76	90	
Sec.		79	38		Wp.		60	40	
Sec.		320			Wp. N W		99	95	
Nr. N E	5	67	50		Sp.		44	50	
Sec.		78	87		Ep. S E		75	70	
Nr. N W		76	29		Wp.		90	20	
Sec.		80			S W		160		
Ep. S E		77	45		Ep. N E	21	56	45	
Wp.		60	92		Wp.		21	63	
Nr. S W		79	85		Sp.		69	17	
Sp.		79	51		Ep. N W		66	10	
Nr. N E	6	76	76		Wp.		88	75	
Sec.		80			S E		160		
Nr. N W		84	52		Ep. S W		65	26	
Sec.		88	55		Wp.		64	50	
Ep. S E		79	00		N E	22	160		
Wr.		80			Ep. N W		94	32	
Ep. S W		80			Wp.		69	24	
Wr.		97	35		Nr. S E		66	51	
Nr.	7	70	51		Sp.		81	71	
Sp. N E		113	75		Ep. S W		61	44	
Sp. N W		121	75		Wp.		86	14	
S E		160			Ep. N E	23	78	97	
Ep. S W		80			Wp.		55	73	
Wr.		98	40		Nr.			65	
Sec.	8	4	92		Ep. N W		79	38	
Ep. N E		68	14		Wp.		96	60	
Wp.		79	82		S E		160		
N W		160			Ep. S W		90	27	
Sec.		320			Wp.		55	11	
Ep. N E	9	80			Sec.	24	640		
Wp.		71	66			25	640		
Nr. N W		77	53			26	640		
Sp.		66	02			27	640		
S Ep.		109	62			28	640		
Nr. S W		96	00			29	640		
Sp.		98	34		Ex.	30	320		
Sec.	10	640			Ex. N W		80		
	11	640			Wr.		79	19	
	12	640			N W		11	30	
Ep. N E	13	99	26		Ex. S W		80		
Wp.		77	93		Wr.		97	32	
N W		160			Ex.	31	320		
S Ep.		122	16		Ex. N W		80		
Nr. S W		91	80		Wr.		97	32	
Sp.		69	13		Ex. S W		80		
Sec.	14	320			Wr.		97	44	
N W S E		126	08				18718	65	
S Ep.		25	61						
Sp.		10							
		9816	47						

Islands in Grand River

Township No. 4 N. Range No. 2 W. Mer. Mich.

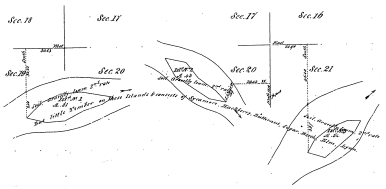

Note. No Island lies within any other Section than that to which it is connected by course and distance to Section line

Meanders of								
Posts	Courses	Ch.s Lks	Posts	Courses	Ch.s Lks	Posts	Courses	Ch.s Lks

Trav. Iteration 20 Lks

Islands Scale 4 Chains to an Inch.
Main land 80 . . . .

Total number of Acres 78

Surveys Designated.		By Whom Surveyed.	Date of Contract.	Amount of Surveys M.	Ch.s	Lks	When Surveyed.	When Changed in the Surv.r Gen.l's acc.t
Township lines.								
Subdivisions.		That. Whitsley	Instructions Aug. 2nd 1834				3rd June 1855	

The above Map of Township No. 4 North of Range No. 2 West of the Principal Meridian of Michigan is strictly conformable to the field notes of the survey thereof on file in this Office which have been examined and approved.

Surveyor Generals Office. Detroit June 24 1856

Leander Chapman Surv.r Genl

Reg.d Copy made