Re-Survey

Township N.o 21 N, Range N.o 5 E, Mer. Mich.

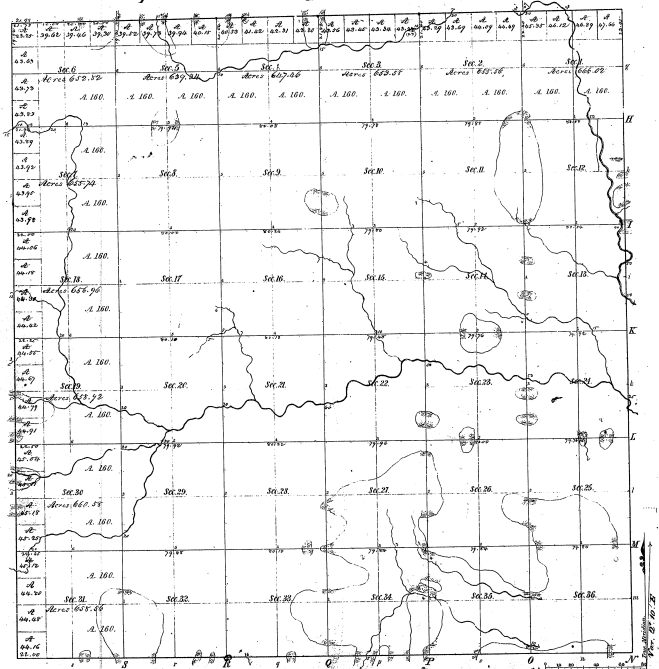

Meanders of

Poles	Courses	Chains	Poles	Courses	Chains	Poles	Courses	Chains

Total number of Acres 23,065.54

Surveys Designated	By Whom Surveyed	Date of Contract	Amount of Surveys	When Returned	When Approved
Township lines	Lyne S. Coleman	July 12th 1837	M. 68 80 / 24 57 NE.	1st of 1838	1st of 1839
Subdivisions	Sylvester Mallett	Oct. 19th 1841	68 80	1st of 1844	1st of 1844

The above Maps of Township N.o 21 North of Range N.o 5 East of the Principal Meridian Michigan is strictly conformable to the field notes of the survey thereof on file in this Office, which have been examined and approved.

Surveyor Generals Office
Cincinnati, February 6th 1845

William Johnston
Surveyor General

22-39