Re-Survey

Township No. 23 N. Range No. 5 East Mer. Mich.

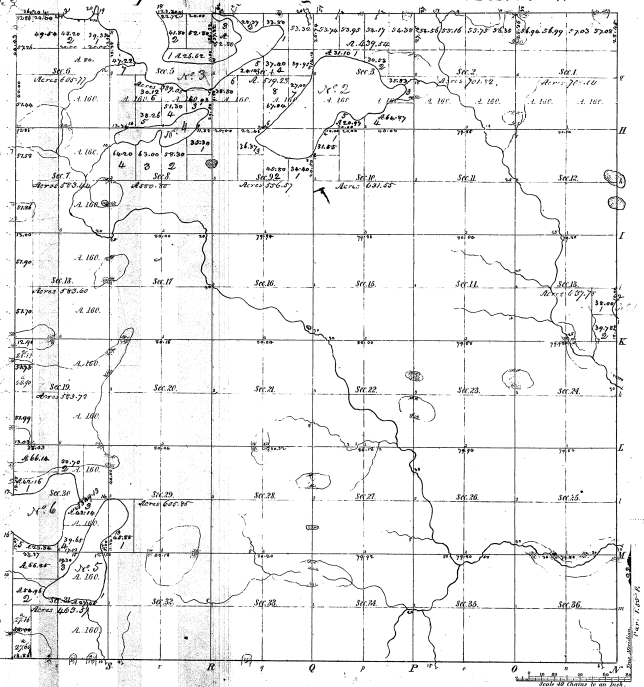

Meanders of					
Posts	Courses	Chs. Lks.	Posts	Courses	Chs. Lks.

22-32

22-32

Total number of Acres 21,739.51

Surveys Designated	By Whom Surveyed	Date of Contract	Amount of Surveys	When Surveyed	Whole Ins. Cor. and Ch. in the Sup. Gen. Ins. Acct.
Township Lines	[illegible]	Feb. 14 1837	24 M. 02 Ch. 94 Lks.	2nd Qr. 1835	1st Qr. 1839
Subdivisions	J. H. Mullett	Oct. 19 1844	76 M. 39 Ch. 46 Lks.	4th Qr. 1844	

The above Map of Township No. 23 N. of Range No. 5 East of the Principal Meridian, Michigan, is strictly conformable to the field notes of the survey thereof on file in this Office, which have been examined and approved.

Surveyor General's Office.
Cincinnati, Feb. 14th 1845

William Johnston
Sup. Genl.