

PLAT OF AN ISLAND

IN


HAGERMAN LAKE

in Sec. 2, T. 42 N., R. 36 W., P.M.,

MICHIGAN.

Surveyed by Walter E. Hoffman, U.S. Surveyor, Sept. 10-11, 1912,
under special instructions from the Com' G.L.O., bearing date June 28, 1912,

Scale: 10 chs to an inch.

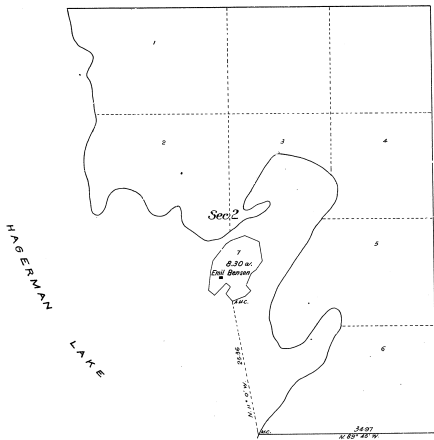

43-40
②
43-40

Department of the Interior,
General Land Office,
Washington, D.C., June 29, 1913.

The above is a correct plat of survey of an Island in Hagerman Lake, in Sec. 2,
T. 42 N., R. 36 W., P.M., Michigan, executed by Walter E. Hoffman, U.S. Surveyor, in pur-
sue of special instructions from the Commissioner of the General Land Office,
bearing date June 28, 1912, and is strictly conformable to the field notes of survey
thereof on file in this office, which have been examined and approved.

W. E. Hoffman
Commissioner and ex officio
U.S. Surveyor General for Michigan.