


Township 1° 43' N Range 1° 35' W Men. Mich.

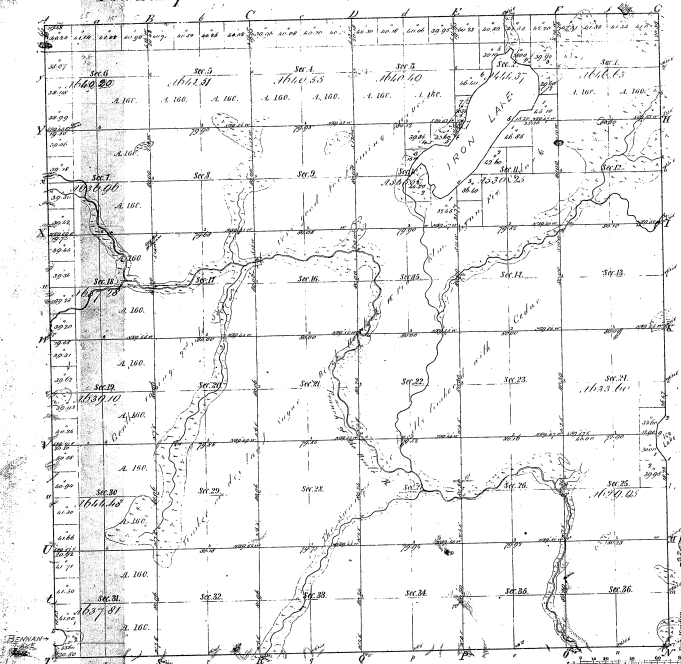

Standard of
 1848 1850 1852 

44 3

44-33

Standard
 5 miles & ch. 66 ft

Total number of Acres 22548.58

Section	By whom surveyed	Date of Contract	Amount of Survey	When Surveyed	Range of the land in the Survey
1-36	John J. ...	April 11, 1871	22,548.58	1871	1° 35' W

The above copy of Township 1° 43' North of Range 1° 35 West of the Principal Meridian is a true and correct copy of the original survey map on file in the Office, which has been examined and approved.

Survey General Office
 Dec. 6, Jan 24, 1872
 Charles H. ...
 Geo. ...