


Township 46 N. Range 31 W. Mer. Mich.

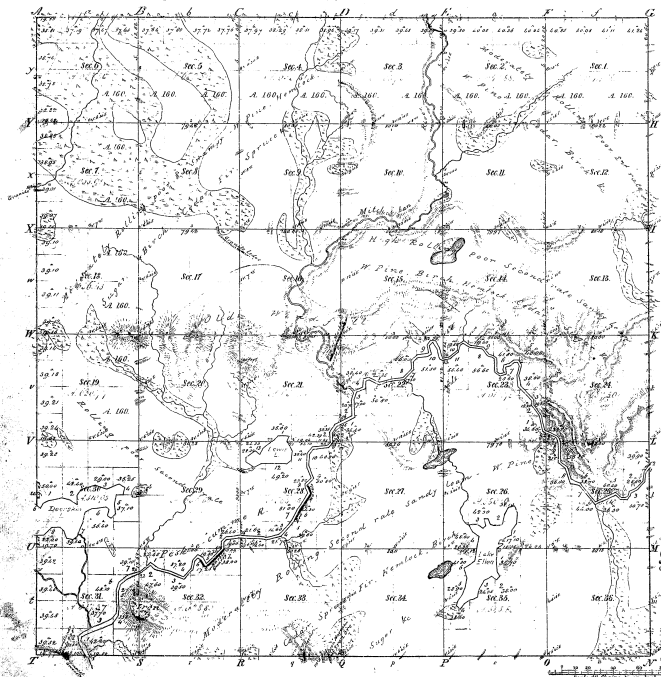

Boundaries of			
North Course	East Course	South Course	West Course
115° 45'			
25 Paces 20 1/2 18 1/2			

45-25

Total number of Acres 358.0					

The above Map of Township 46 N. 31 W. Part of the Principal Meridian Michigan is truly conformable to the field notes of the survey thereon file in this office and has been examined and approved

Surveyor General's Office
 Grand Rapids, Mich.
 Charles A. Tildes
 Surveyor General