Township No. 44 N. Range No. 32 W. Mer. Mich.

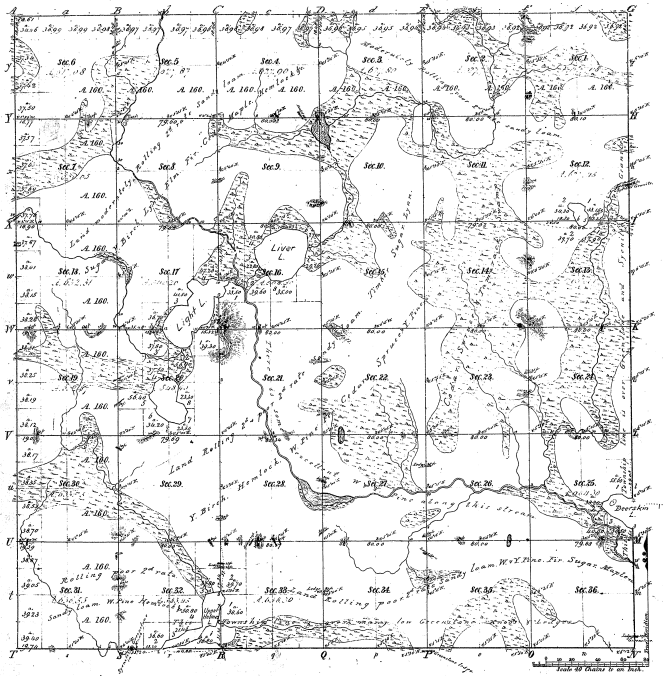

Meanders of								
Posts	Courses	Ch. Lk.	Posts	Courses	Ch. Lk.	Posts	Courses	Ch. Lk.

44-29

44-29

Total number of Acres. 22,691.28

Surveys Designated	By Whom Surveyed	Date of Contract	Amount of Surveys M.	Ch.	Lks.	When Surveyed	When p.d for and ch.d in the Surv. Gen.l Ofc.
Township lines	[illegible]	Feby 1846	11	78	88	2d Oc. 1846	
Subdivisions	[illegible]	April 27 1849	67	61	46	2d & 3d 1849	

The above Map of Township No. 44 North of Range No. 32 West of the Principal Meridian Michigan is strictly conformable to the field notes of the survey thereof on file in this Office, which have been examined and approved.

Surveyor General's Office,
Detroit April 13. 1850

Charles Noble
Surv. Genl.