Township. N° 45 N. Range. N° 34 W. Mer. Mich.

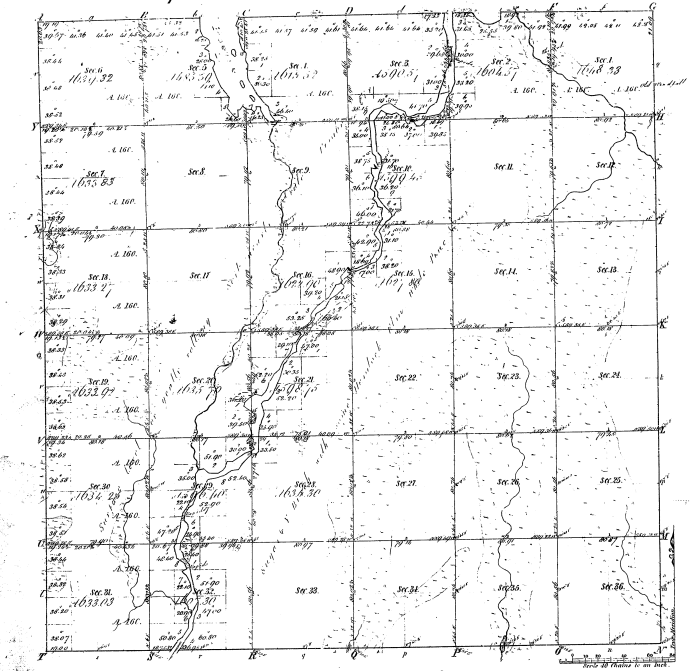

Meanders of
Public Reserves the 12th
Public Reserves the 13th
Public Reserves the 14th

Total number of Acres 22134.60

Surveys Designated	By Whom Surveyed	Date of Contract	Amount of Surveys	When Surveyed	When Plat of the said Surveys in the State Office
Township lines	W. A. Burt, Deputy Surveyor	Sept. 7, 1846	72 miles 32 chains	5th Quarter 1846	
Subdivisions	Same, & Deputies		216 miles 40 chains		

The above Map of Township N° 45 North of Range N° 34 West of the Principal Meridian Michigan is strictly conformable to the field notes of the surveys thereof on file in this Office, which have been examined and approved.

Surveyor Generals Office
Detroit May 22nd 1847

Chas. Noble
Surv. Gen.

44-23