


Township 15th 45thN. Range 1st 36thW. Mer. Mich.

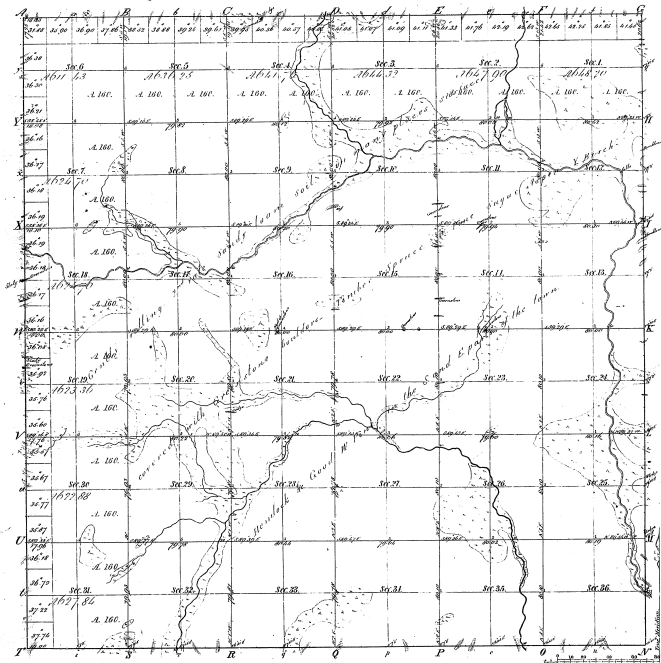

Memorandum of

44-20

44-25

Total number of Acres 22053.36

Survey Designated	By Whom Surveyed	Date of Contract	Amount of Survey	When Surveyed	Plan of the land and its situation

The above Map of Township 15 45 North of Range 1 36 West of the
Principal Meridian Michigan is strictly conformable to the field notes
of the survey thereon on file in this Office which have been examined and approved.

Surveyor General's Office
Detroit Aug 24/1872

Charles A. Allen
Supt. Genl.