Township № 46 N. Range № 31 W. Mer. Mich.

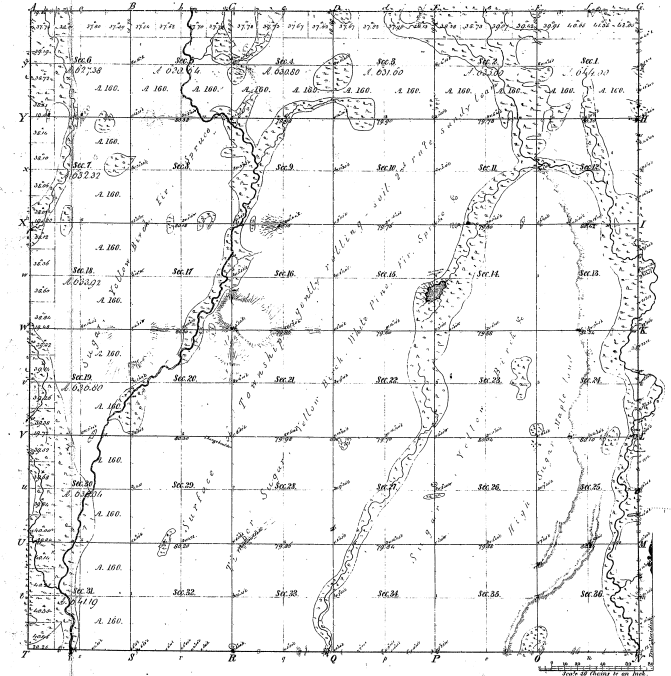

Meanders of

Prob. Courses	Dist.	Prob. Courses	Dist.	Prob. Courses	Dist.

Total number of Acres 22,083.20

Surveys Designated	By Whom Surveyed	Date of Contract	Amount of Surveys	When Surveyed	When & to whom sold, & in the Sur. Gen.ls Office
			M. Ch. Lks.		
Township lines	Wm. A. Ld. & A. S. Fitch	Dec. 10th 1840		1840	
Subdivisions	Harvey Miller	29th Aug. 1843 & Dec. 18th 1843	22 80 11.85	1843	

The above Map of Township № 46 North of Range № 31 West of the Principal Meridian Michigan is strictly conformable to the field notes of the survey thereof on file in this Office, which have been examined and approved.

Surveyor Generals Office
Detroit January 27th 1844

Lucius Lyon, Surv.r Gen.l

45-18