Re Survey and Correction of a part of

Township N°16 N. Range N° 4 W. Mer. Michigan

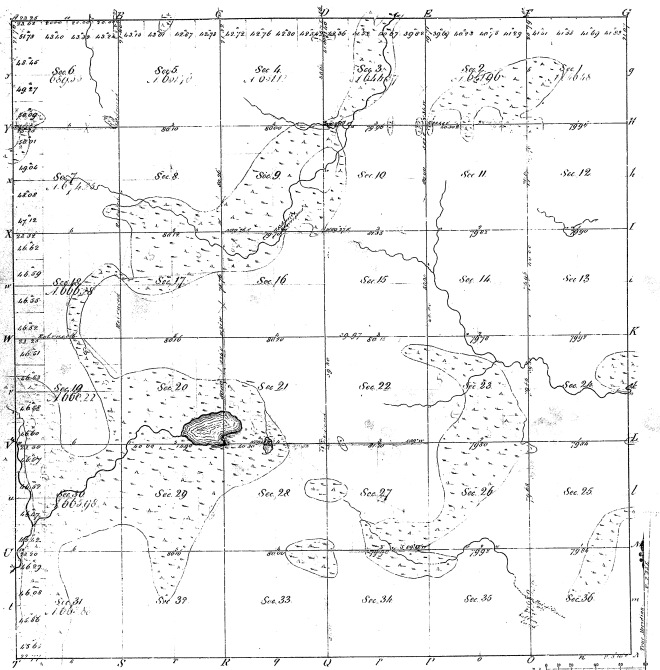

Boundary of								
Tract	Current	Old Lines	Corn	Courses	Chains	Trees	Corn now	Old Lines

13-20

13-20

Note — The lines shaded yellow have been resurveyed and corrected.
The lines shaded blue have been resurveyed and the remarks as to the lines of the old survey extract from the original plat.
The outlines in blue ink have been changed as to progress of the resurvey.

To al number of acres 21,611.80

Showing the resurvey, surveyed & corrected.

Surveys Segregated	By Whom Surveyed	Date of Contract	Amount of Surveys M.	Ch.	Lks.	When Surveyed	When Changed to the Corrected Survey
Township lines.	John Hodgson	Jan.y 12. 1837	12.	03.	54	2nd Quar. 1837	
Re. Surveys	Wm A. Burt		12.	06.	69	2nd Quar. 1856	
Subdivisions.	Henry Nicholson	July 22d 1837				4th Quar. 1837	
Corrections	Wm A Burt		10.	37.	54	2nd Quar. 1856	

The above Plat is the Township N.o 16 North of Range N.o 4 West of the Principal Meridian Michigan, is strictly conformable to the field notes of the survey thereof on file in this Office, which have been examined and approved.

Surveyor Generals Office,
Detroit Sept 4 1861

Charles Noble Surv.r Gen.l