12-20

Re Survey and correction of a part of

Township No. 16 Range No. 5 W. Mer. Mich.

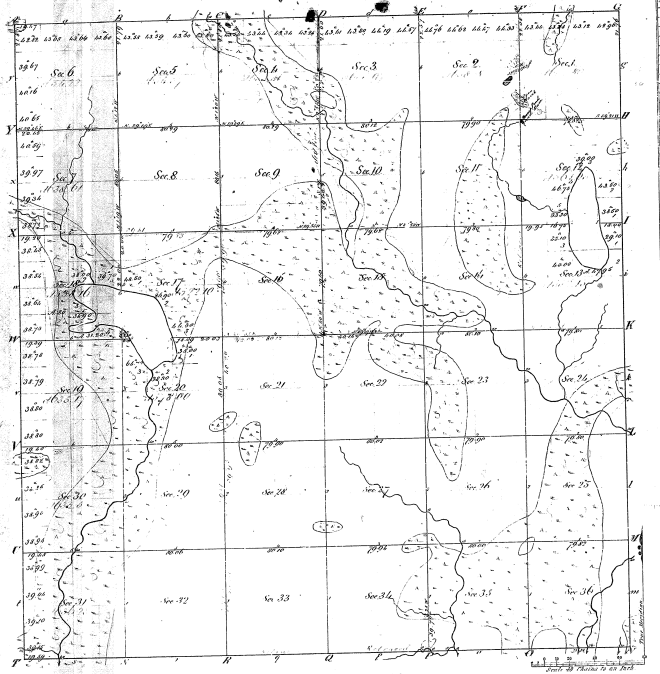

Meanders of									
Posts	Courses	Ch's Lk's	Posts	Courses	Ch's Lk's	Posts	Courses	Ch's Lk's

Note. The yellow shaded lines have been remeasured and corrected.
The blue shaded lines have been resurveyed, and the remainder are the lines of the old survey, copied from the original plate. The contents in blue ink have been changed in consequence of the resurvey.

Total number of Acres 2666.45

Surveys Designated	Who Were Surveyed	Date of Contract	Amount of Surveys M. Chs. Lks.	When Surveyed	When Changed in the Surveys and Acts
Township lines.	John Hodgson	Jany 12 1837	12. 01. 35	2nd Quar 1837	
Re Surveys	Wm A Burt		13. 01. 28	2nd Quar 1850	
Subdivisions of Sec.	H. Nicholson	July 28. 1837		4th Quar 1837	
Re Measurements	Wm A Burt		6. 40. 99	2nd Quar 1850	

Showing the survey remeasurement & correction

The above Map in Township No. 16 North of Range No. 5 West of the Principal Meridian Michigan is strictly conformable to the field notes of the survey thereof on file in this Office, which have been examined and approved.

Surveys Generals Office.
Detroit Septemb. 11 1851.

Charles Noble Surv. Genl