


Township (N.I south, Range N.H East (and Ten.)

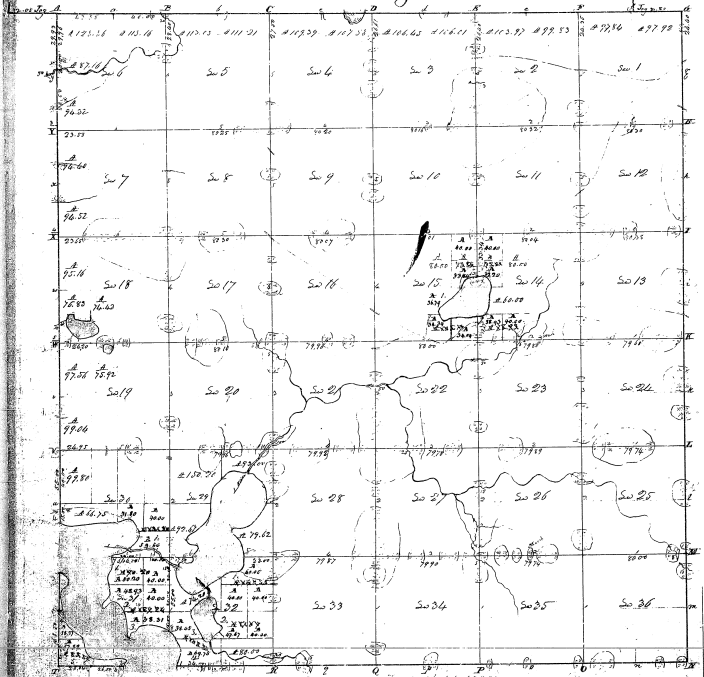

Surveyed in Nov 1895 by Joseph Wampler I.S.

Wampler

11
1
0
0