


Township (N.E. 1/4), Range (N.E. 6th) (cont'd. 11-)

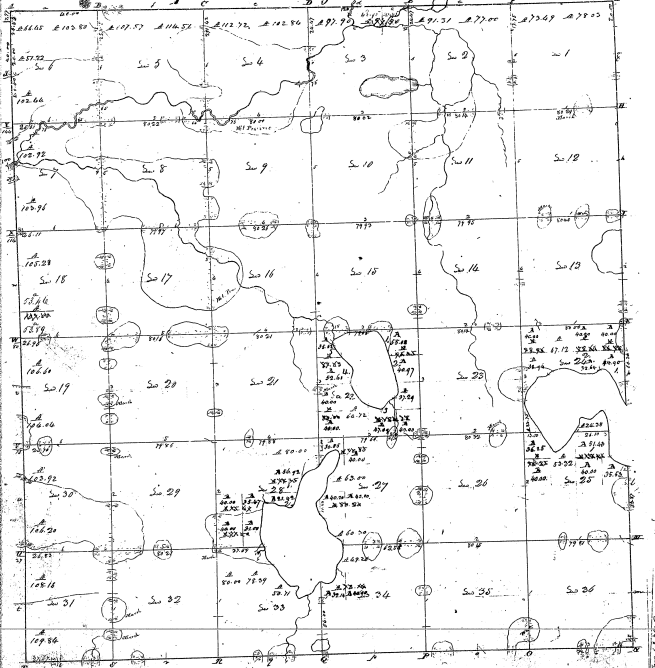

Surveyed in March 1835 by Harry Porter

Scale of 1" = 1000'

30-10

1000'