



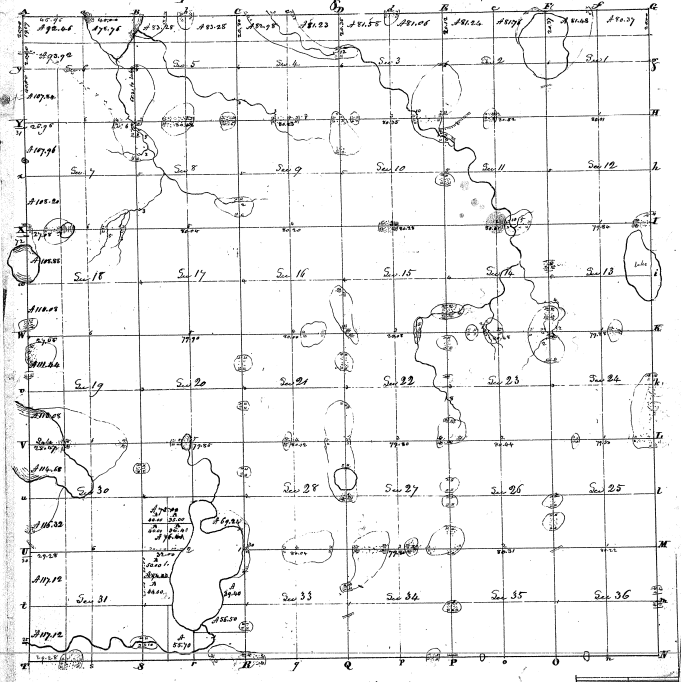

Total No. 23 101-77


30-6

150-6