



20

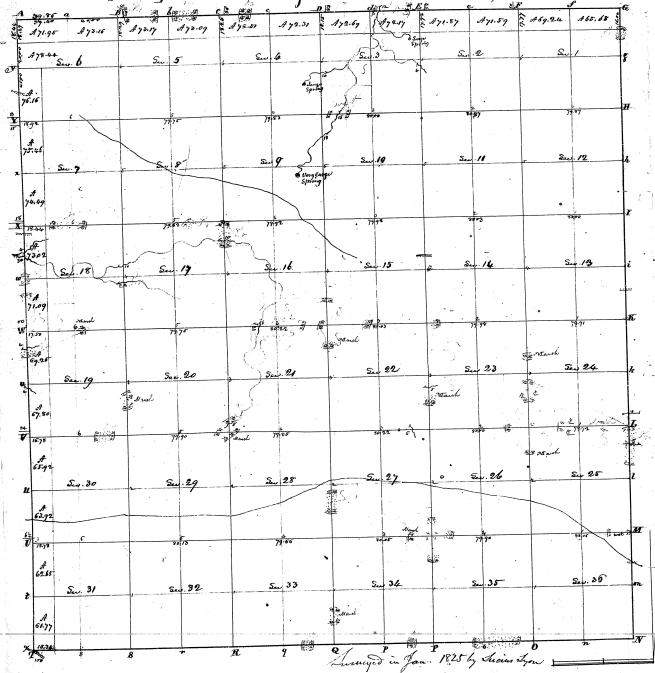

3-13

3-13

