



12

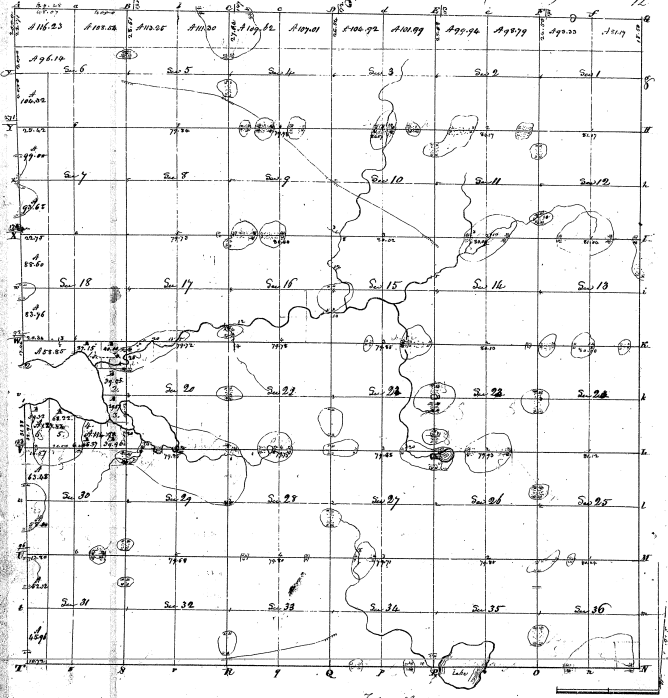

Total A. 23,079.04

0.001

Henry Parker, D. S.

Surveyed Feb. 1854

30-11

30-11