


Township N.W. south, Range N.W. west, (and so)

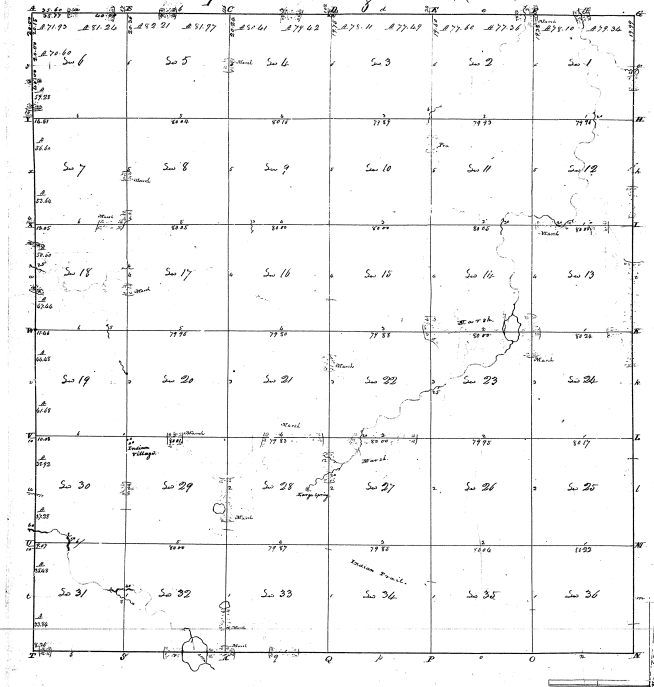

3-29

3-29