


Township N. III South, Range N. III West Mer. (M. Ter.)

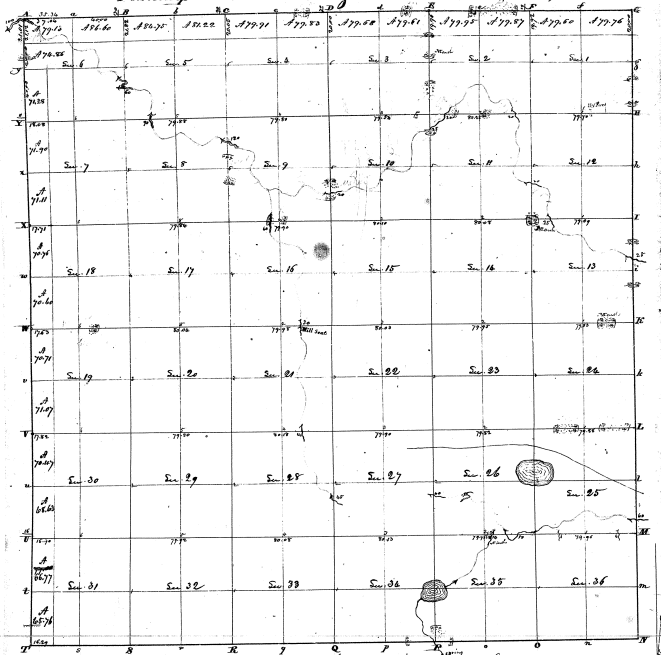

Surveyed in Dec. 1835 by Lewis & Co.

3-26

3-28