Township No. III South, Range No. X West Mer. (Mic. Ter.)

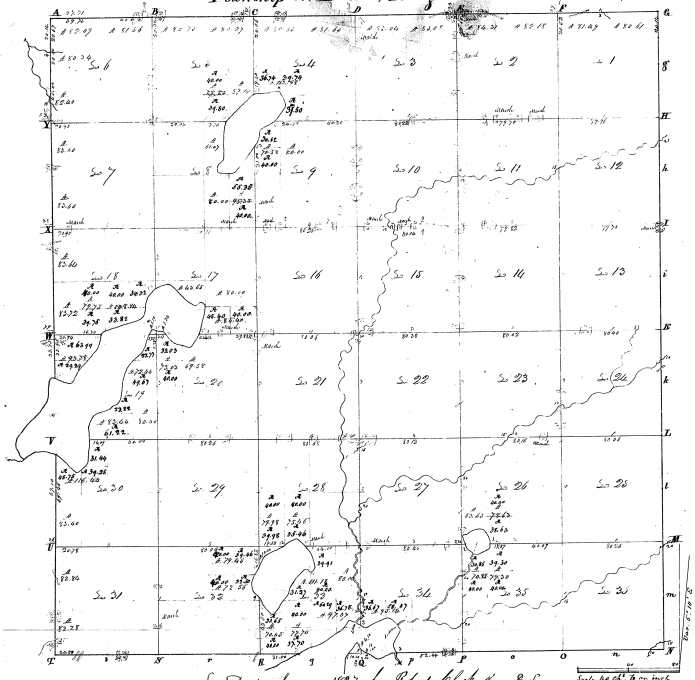

Surveyed in January 1827 by Robert Clark Jr. D. S.

Scale 40 chs. to an inch.

3-2-1

Sections	Contents Acres.	Sections	Contents Acres.
Lot 1	50 61	NE 17	320
Lot 2	50	NW SE	50
SW NW	51 49	SW	50 44
Lot 3	50	NW SW	50 44
Lot 4	320	SW SE	1 24
SW SE 2	1 15	NE SE 18	160
Lot 1	50	E. NW	50
Lot 2	50 01	NW	52 66
Lot 3	50	NW SE	108 76
Lot 4	320	SE	1 10
SW SE 3	50 03	E. SW	79 70
Lot 1	50	NW	65 72
Lot 2	50 04	NE E pas	72 44
Lot 3	50	SW pas	53 28
Lot 4	320	E. SE	80
SW SE 4	51 65	NW	53 44
Lot 1	50	SE 20	160
SW NW	50 65	E. NW	49 35
Lot 2	50	NW	72 03
Lot 3	50	SE	320
Lot 4	110 95	SW 21	640
SW SE 5	52 27	22	640
Lot 1	50	23	640
Lot 2	50 70	26	640
Lot 3	50	27	640
Lot 4	47 10	28	320
NW	79 80	SE	160
SE	100	E. SW	78 53
SW SE 6	51 55	NW	53 86
Lot 1	50	SE	320
Lot 2	52 09	NW 28	320
Lot 3	50 56	SE	160
Lot 4	100	E. SW	76 44
SE	100	NW	79 78
SW	52 40	29	640
SE 7	320	E. SE 30	320
NW	50	NW	113 46
SW	53 01	SW	80
SE	50	NW	83 60
NW	53	E. SE 31	320
E pas	61 07	E. NW	80
SE	95 50	NW	82 84
	80	E. SW	80
NW	320	NW	82 28
SW SE 9	160	NW NE 32	77 64
	80		78 28
NW	78 62	SW	160
SW	320	SW	320
SE 10	640	E. NE 33	80
11	640	NW	111 18
12	640		10
13	640	SE	97 27
14	640	E. SW	77 50
15	640	NW	78 95
16	640	SW 34	320
17	640	SE	160
		S. NW	95 10
		NE 35	160
		E. SW	79 30
		NW	70 98
		SW	320
		SE 36	640
			11793 40
			1011 1/44
			2809 6-14

Tola