




MS-1

Island in Lake  
Township N<sup>o</sup> 3 S. Range N<sup>o</sup> 12 W. Mer. Mich.

2-11

②

241

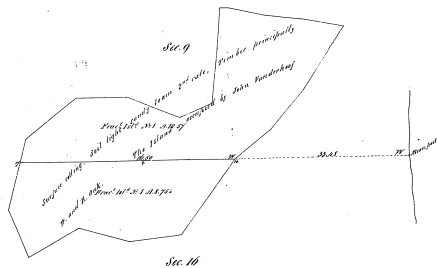

Surveyed by T. H. Murphy (under Instructions May 16, 1854) in 1856

Scale 4 Chains to an Inch No. 236 B

The above Map of Township N<sup>o</sup> 3 South of Range N<sup>o</sup> 12 West of the  
Principal Meridian of Michigan is truly conformable to the field notes  
of the Survey thereof on file in this Office, which have been examined and approved

Surveyor General's Office  
Detroit April 15<sup>th</sup> 1857

A. L. Emery  
Supt. Land