



2-14

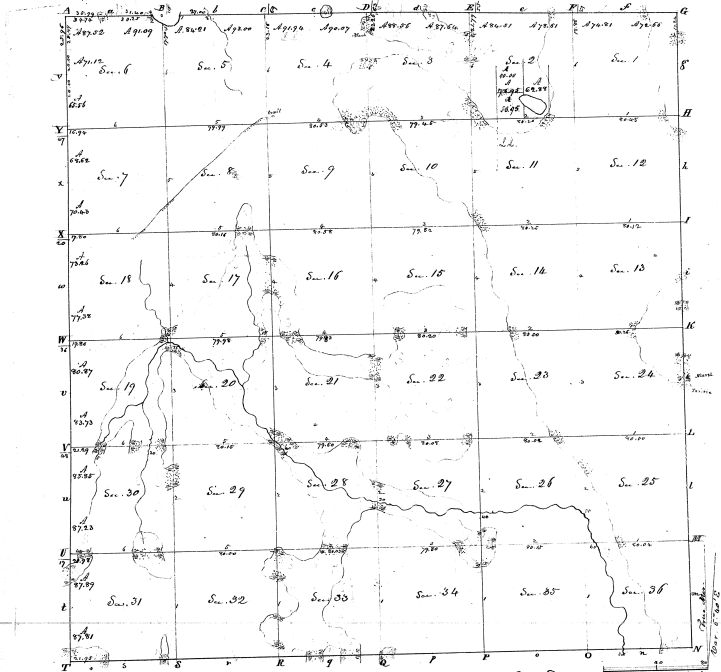


Surveyed in December 1829 - by Edward H. Sells, D. S.

2-14

3378.88

1151.18

3378.88