Resurvey

Township. N.o 25 N. Range. N.o 6 W. Mer. Mich.

15-2-2

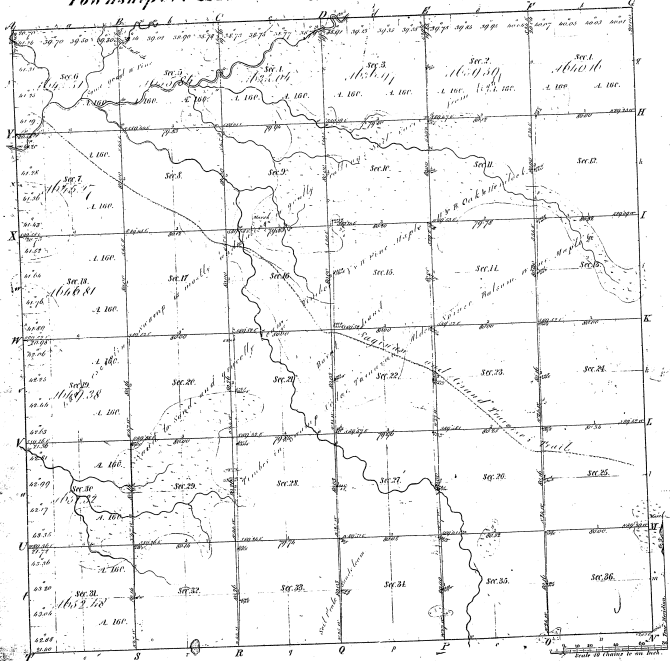

Meanders of							
Posts	Courses	Chs.	Lks.	Posts	Courses	Chs.	Lks.

Total number of Acres 23076.27

Surveys Designated	By Whom Surveyed	Date of Contract	Journal of Surveys	When Surveyed
Township lines	Orlando Wentworth	May 16th 1836	34.65 Chs.	1st Quar. 1837
Subdivisions	Geo. H. Cannon	April 20 1852	60.05.97	3d Range. 1852
East Boundary	Wm. M. Hall	Dec. 15 1839	6.00.00	2d Quar. 1839

When Corners marked in the Year Gen.l not'd.

The above Map of Township. N.o 25 South of Range. N.o 6 West of the Principal Meridian Michigan is strictly conformable to the field notes of the survey thereof on file in this Office, which have been examined and approved.

Surveyor General's Office
Detroit Dec. 3d 1852

Chas. Noble
Surv.r Gen.l