Resurvey.

Township No. 26 N. Range No. 7 W. Mer. Mich.

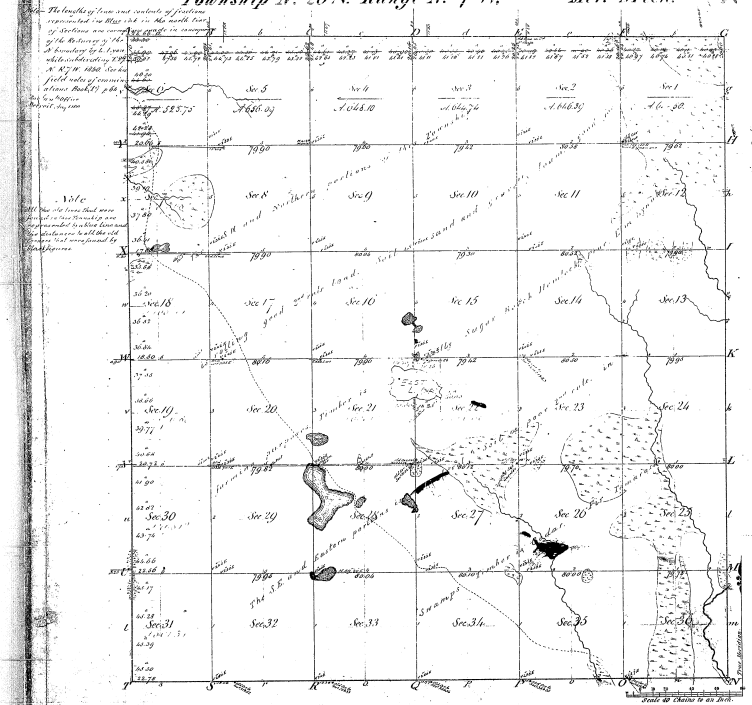

Meanders of

Posts	Courses	Ch's Lk's	Posts	Courses	Ch's Lk's	Posts	Courses	Ch's Lk's
[illegible]								
[illegible]								
Side of Lake								

Total number of Acres 2 101 41

Surveys Designated.	By Whom Surveyed.	Date of Contract.	Amount of Surveys M. Ch's Lk's	When Surveyed.	When Charged in the Surv. Genl's acct.
Township Lines	Wm. A. Burt L. Brock	Mar. 5 1850	5 62 70 [illegible]	[illegible]	
Subdivisions.	Wm. A. Burt		60 04 35	3rd qr. 1849	

The above Map of Township No. 26 North of Range No. 7 West of the Principal Meridian Michigan is strictly conformable to the field notes of the survey thereof on file in this Office which have been examined and approved.

Surveyor General's Office.
Detroit Dec. 3rd 1849

Lucius Lyon, Sur. Genl.

15-18