


Resurvey
 Township 1° 27' N. Range 1° 6' W. Mer. Mich.

15 14

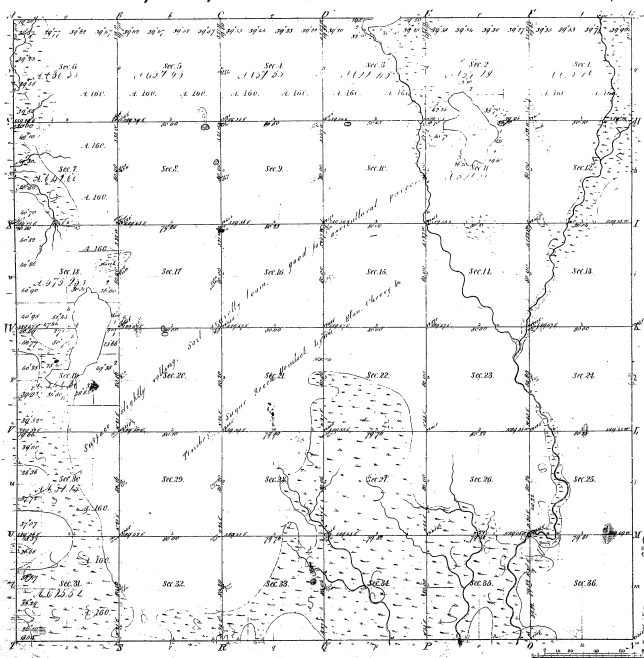


15-14

Total number of Acres 21,711.13

Survey designated	By Whom Surveyed	Date of Contract	Amount of Section	When Surveyed	When made out and the Section closed

The above map of Township 15 27 North 15 6 West of the Principal Meridian Michigan is a study conformable to the field notes of the survey thereof as filed in the office which have been approved and approved
 Surveyor General
 Charles A. Johnson
 Detroit August 7 1853

Charles Johnson
 Surveyor General