Township No. 28 N., Range No. 5 West Mer. (Mich.)

15-17

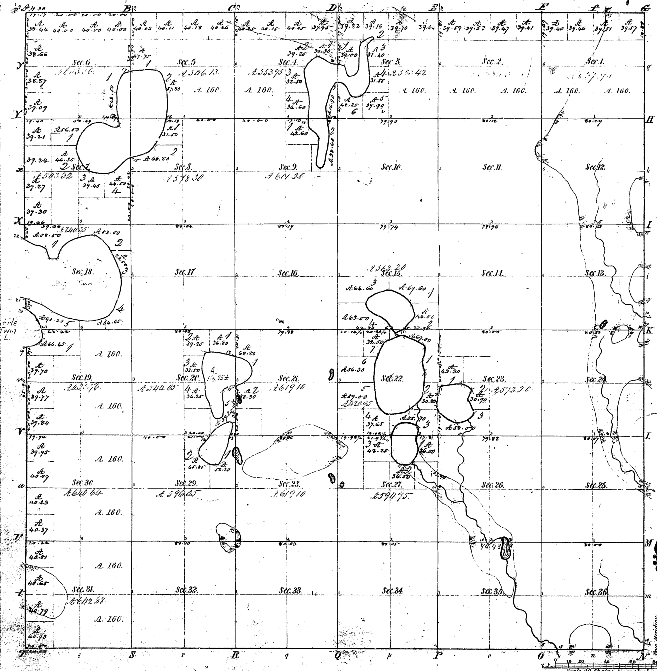

Meanders of Small Lakes.

Posts	Courses	Ch. Lk.
Lake in Sec. 22 & 23		
1	S40E	8.50
	S78E	12.50
	N72E	8.00
	N40E	6.00
	N37W	10.00
	N27E	11.00
	N63W	11.00
	S82½W	10.50
2	S14W	9.50
	S25½W	5.00
	S5½E	3.00
1	S41E	3.10
Lake in Sec. 22 & 27		
3	N6E	7.50
	N67W	9.00
	S82W	8.00
	S47W	6.00
4	S5W	5.61
	S2W	12.00
	S17E	7.00
	S56E	8.00
	N88E	8.00
	N27E	13.00
	N5W	4.50
3	N5W	7.60
Lake in Sec. 15 & 22		
5	N33E	15.00
	N38W	16.00
	N59W	12.00
	S77W	12.00
	S43W	12.00
	S40E	9.50
	S61½E	8.00
6	S43E	12.10
	S44E	4.00
5	N67E	7.51
Lake in Section 22		
Beg. 5	South	4.20
7	S74W	16.50
	S27W	16.50
	South	6.00
	S12½W	8.00
	S6E	16.00
	S33½E	13.00
	N84E	14.00
	N60E	19.00
	N4E	17.50
	N9W	13.50
	N15E	11.00
	N65W	17.60
Lake in Sections 3, 4 & 9		
9	N1W	15.50
7	N32½E	13.60
	S83E	3.00
	S41½E	13.00
	N85½E	8.00
	N42E	7.00
	N4E	12.50
	N7W	20.50
	N45E	7.50
	N66W	1.00
	S68½W	10.00

Posts	Courses	Ch. Lk.
	S54W	25.00
	S56W	6.00
	N29W	11.00
	West	6.10
	N70W	9.50
	N59W	8.00
	S42W	12.00
	S4E	11.50
	S11E	14.50
10	S10W	13.00
	S10E	8.00
	S60E	8.00
	S4W	23.00
	S50E	4.50
	N65E	4.00
	N11E	20.50
	N6½W	5.90
Lake in Sec. 20 & 21		
11	N72E	7.50
	N30E	4.50
	N2E	7.50
12	N66W	13.10
	N78W	9.50
	N88W	13.50
	S12W	10.00
	S6E	11.00
	South	6.25
	S17E	10.50
	S12E	10.50
	S45E	4.50
	N75E	4.50
	N7E	8.50
	N81½W	10.50
	N44E	5.00
11	N83E	8.00
Lake in Sec. 20 & 29		
13	N17E	8.00
	N37W	4.00
	S65W	12.00
14	S35W	7.10
	S45W	14.50
	S12E	8.50
	S67E	11.00
	N81E	5.50
	N39E	4.00
	N21E	9.50
13	N10E	10.58
Lake in Sections 5, 6, 7 & 8		
16	N1W	18.50
	N14W	16.50
	N76W	9.00
17	S83W	15.30
	S74W	6.00
	S20W	13.00
	S7W	10.00
18	S12E	10.90
	S12E	5.00
	S72½W	4.50
	N62W	6.00
	N83½W	9.50
	S55W	13.00
	S14W	14.50
	S27E	10.50
	S37½E	15.50

Posts	Courses	Ch. Lk.
	N84E	13.00
	N45E	14.80
	N66E	18.50
	N32E	18.00
	N11E	7.30
Part of a Lake in Sections 18 & 19		
15	N75E	5.50
	N53E	6.50
	N7E	8.50
	N17W	9.00
	N39W	6.50
	N56W	5.81
21	S66½E	10.00
	S56E	9.50
	S67E	11.00
	S78E	14.00
	East	15.50
	N53E	16.50
	N24E	15.50
	N1½W	15.00
	N19W	15.00
	N24W	14.50
	N66W	16.00
	S76½W	17.00
	S68W	8.50
	S24W	11.00
	S86W	4.50
	N32W	10.00
	N66W	8.50
22	N46W	5.50

Total number of Acres. 21545.53

Surveys Designated	By Whom Surveyed	Date of Contract	Amount of Surveys (M. Chs. Lks.)	When Surveyed	When pd. for and ent. in the Sur. Genl's acct.
Township lines	S. A. Mullett	Feb. 18. 1839	13 79 60	Nov. 1839	
Subdivisions	Mullett & Brevoort			Do.	

The above Map of Township No. 28 North of Range No. 5 West of the Principal Meridian Michigan is strictly conformable to the field notes of the survey thereof on file in this Office, which have been examined and approved.

Surveyor General's Office
Cincinnati Aug. 15 1839

Sur. Genl.