



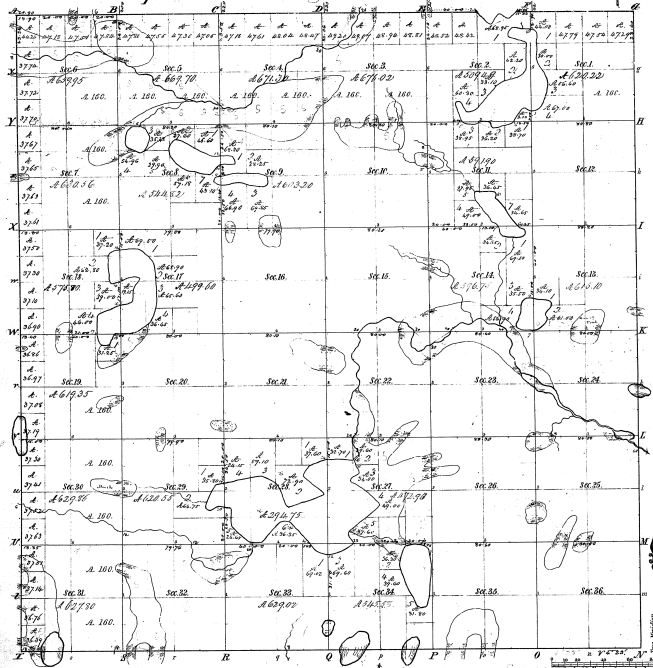


Total number of Acres 21664.22

Survey Established	By Whom Surveyed	Date of Contract	Amount of Survey	When Surveyed	Plat No. and where the Survey was made
Township - lines	A. G. Phillips	Oct. 21, 1826	36 Secs.	1827	1828
Subdivisions	A. G. Phillips	March, 1829	79.44 Ac.	1829	1829


Surveyor General's Office
Grand Rapids, Feb. 24 - 1839

A. G. Phillips

7-5