


Township N^o 10 N., Range V^o 12 W. 2 Mer. Min.

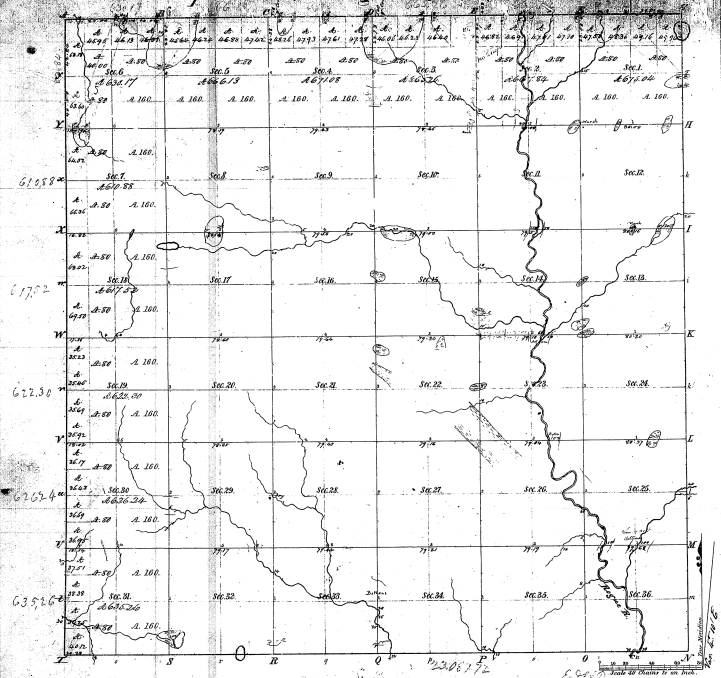

61958
61962
62230
62654
63516

Section	Acres	Owner
1		
2		
Total number of Acres 2387.72

Survey designated	By whom surveyed	Date of Contract	Amount of Survey	When surveyed	W ^o 1/2 and 1/2 of the Section
Township lines	J. Campbell	6.23. 1826	18 3/4 1/2	1827	1/2 1/2 1/2
Subdivisions	W. H. Hall	11. 11. 1828	11 1/2 1/2	1829	1/2 1/2

The above Map of Township N^o 10 North of Range 12 West of the Principal Meridian Michigan is duly conformable to the following description thereof on file in the Office and has been examined and approved
 Charles Granger, Clerk
 December 11th 1838
C. Granger