40-17

Township No. 63 N. Range No. 38 W. Mer. Mich

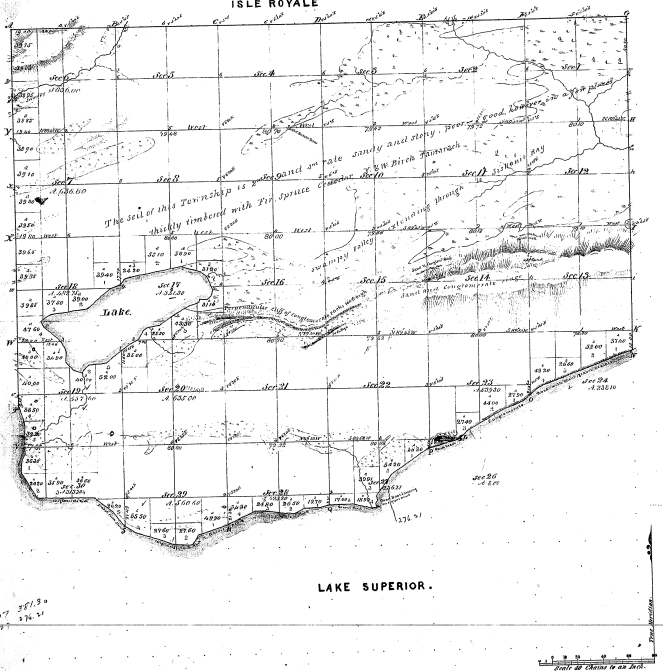

Meanders of							
Posts	Courses	Ch. & Lks.	Posts	Courses	Ch. & Lks.	Posts	Courses	Ch. & Lks.

Total number of Acres 15850.06

Surveys Designated.	By Whom Surveyed.	Date of Contract.	Amount of Surveys M. Ch. Lks.	When Surveyed.	When Changed in the Surv. Genl. acct.
Township lines.	Wm. Ives	Apr. 2d 1848	3 15 00	20 Apr 1848	
Subdivisions.	Wm. Ives	" "	54 24 44	20 Apr 1848	

15930.06

The above Map of Township No. 63 North of Range No. 38 West of the Principal Meridian Mechigan is strictly conformable to the field notes of the survey thereof on file in this Office, which have been examined and approved.

Surveyor General's Office.
Detroit Nov. 6th 1848

Lucius Lyon, Sur. Genl.