# Township No. 18 North Range No. 12 West Mer. Mic.

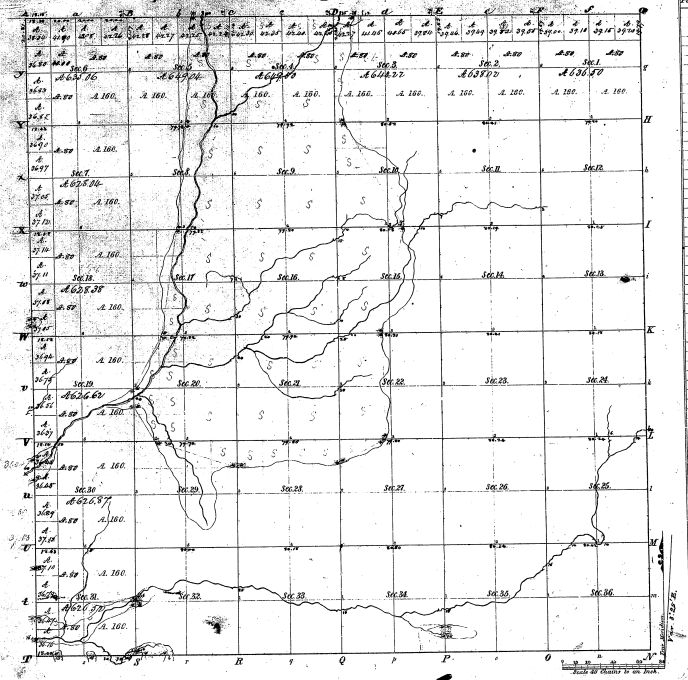


| Meanders of | | | | | | | | |
|---|---|---|---|---|---|---|---|---|
| Posts | Courses | Ch.s Lk.s | Posts | Courses | Ch.s Lk.s | Posts | Courses | Ch.s Lk.s |
| | | | | | | | | |

11-9

Total number of Acres 22988.7[illegible]

| Surveys Designated | By Whom Surveyed | Date of Contract | Amount of Surveys | When Surveyed | When Rec.d for Cert. ch.d in the Sec. Dep.t of Int.r |
|---|---|---|---|---|---|
| Township lines | John Hodges | Jan. 12. 1837 | 23. 36. 75 | 4th D. 1837 | [illegible] 1838 |
| Subdivisions | Same | Jan. 30. 1838 | 59. 75. 18 | 2d D. 1838 | 1st D. 1839 |

The above Map of Township No. 18 N. of Range No. 12 W. of the Principal Meridian, Michigan, is strictly conformable to the field notes of the survey thereof on file in this Office, which have been examined and approved.

Surveyor General's Office,
Cincinnati, Feb. 8. 1839

[illegible] Sur. Gen.l