
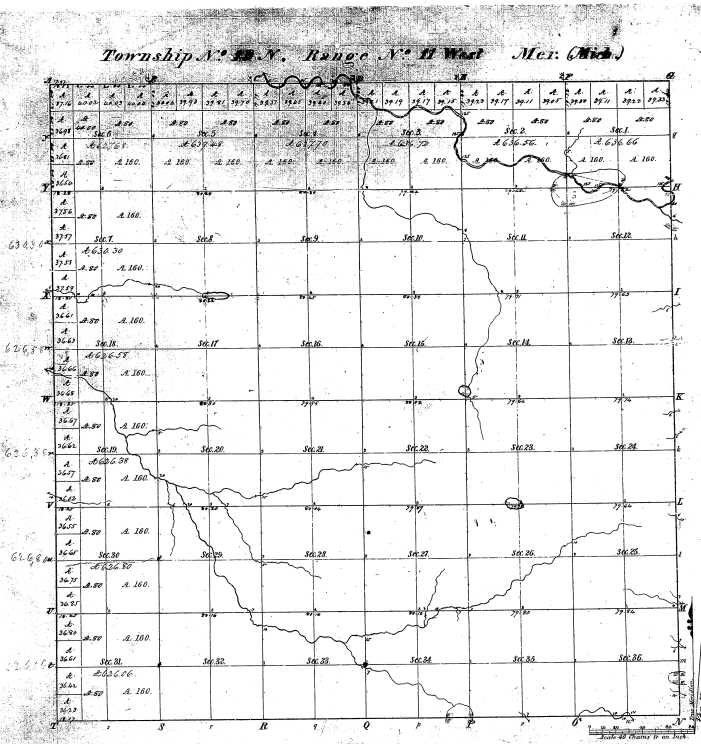

Meanders of

North Courses	Dist.	North	Courses	Dist.	North	Courses	Dist.

Total number of Acres 22952.92

Surveys Designated	By Whom Surveyed	Date of Contract	Amount of Surveys	When Surveyed	When Plats and Diff.ces thereof were Rec.d in Gen.l Office	When Plats were Approved
Exterior lines	[illegible]	[illegible]	[illegible]	[illegible]	[illegible]	[illegible]
Subdivisions	[illegible]	the 24th 1838	22952 92	1838	1838	1839

The above Map of Township N° 39 North of Range N° 11 West of the Principal Meridian Michigan is strictly conformable to the Field notes of the Survey thereof returned into this Office by the Surveyor

Surveyor General's Office, Cincinnati, Feb 28th 1839

Deputy Clerk