


Township No. 20 N., Range No. 12 West Mer. (Mich.)

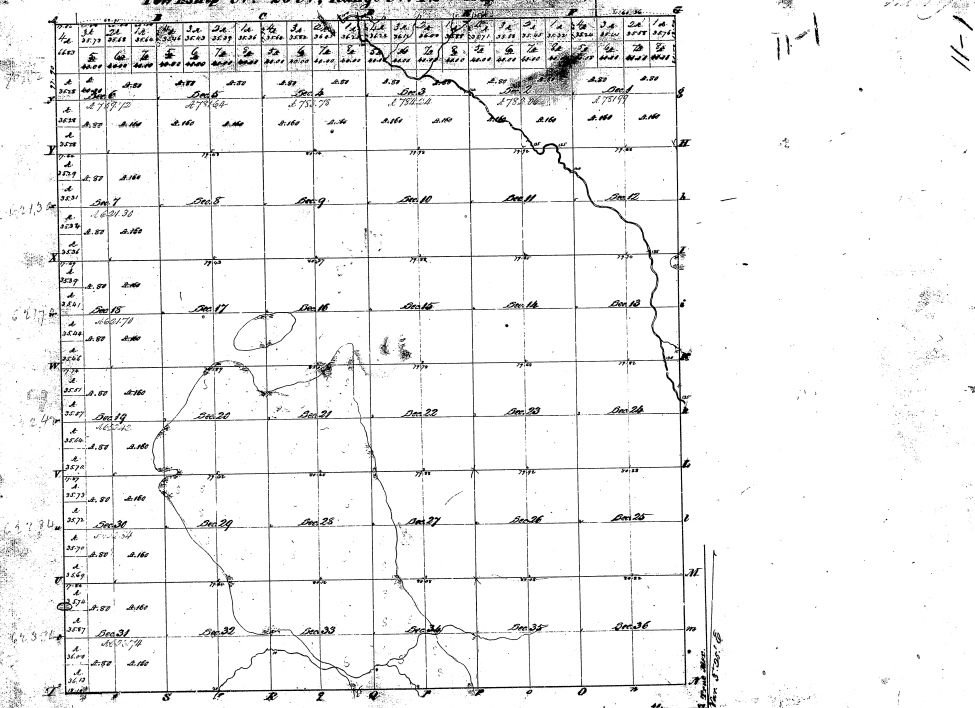


The above Map of Township No. 20 N., Range No. 12 W., after Principal Section has been made & finally completed, all the full title of the same being on file in this Office, which have been claimed and approved by Surveyor General's Office  
 December, 26, 1839  
 J. P. Cleary