


Township N.° VII North, Range N.° XI East Mer. (Mich. Ter.)

113

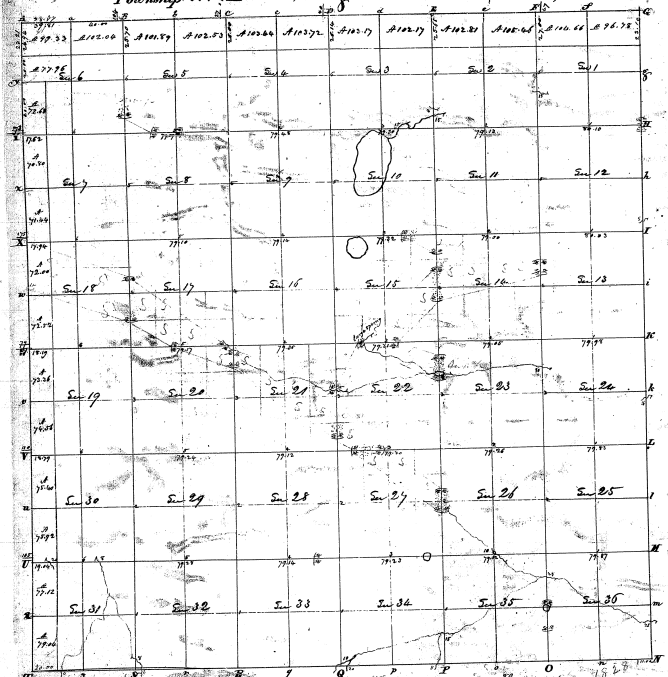

27-14

27-14

23. 240



James G. ...