Re-Survey

Township No. 28 N. Range No. 12 W. Mer.

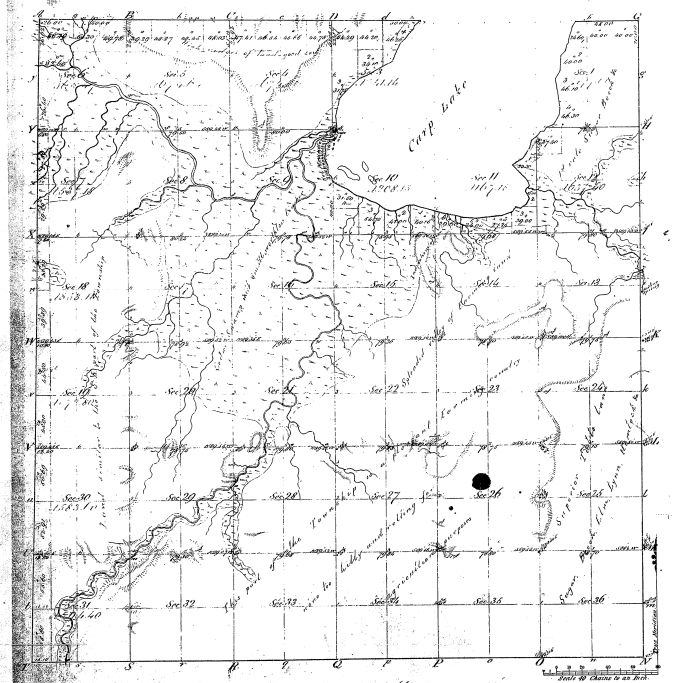

Boundary of								
Posts	Courses	Ch. Lks.	Posts	Courses	Ch. Lks.	Posts	Courses	Ch. Lks.

Total number of Acres 20566.50

Survey Designated.	Be When Surveyed.	Date of Contract.	Amount of Surveys M. Ch. Lks.	When Surveyed.	When Charged in the Surv. Genl. Acct.
Township Lines	John Hedman	Jan. 24. 1830	5. 75. 10	3rd Quar. 1830	
Re-Surveys by Subdivisions	Orange Risdon		6. 00. 00	3rd & 4th Quar. 1830	
	Orange Risdon	Bond Jan. 1830	58. 74. 00	3rd & 4th Quar. 1830	

The above Map of Township No. 28 North of Range No. 12 West of the Principal Meridian, Michigan, is strictly conformable to the field notes of the survey thereof on file in this Office which have been examined and approved.

Surveyor Generals Office
Dec. 1 Nov. 12. 1851

Charles Noble Sur. Genl.

16 G 21