
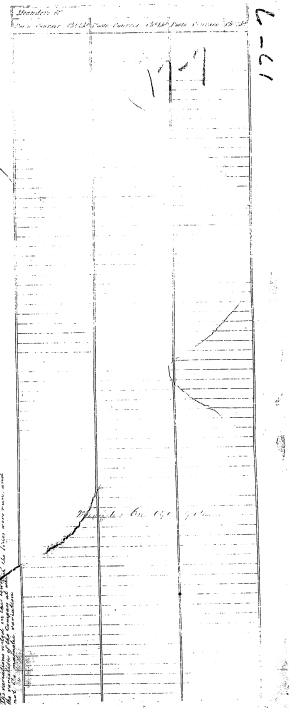


Re Survey  
 Township N<sup>o</sup> 28 N. Range N<sup>o</sup> 14 W. Mer. Mich.

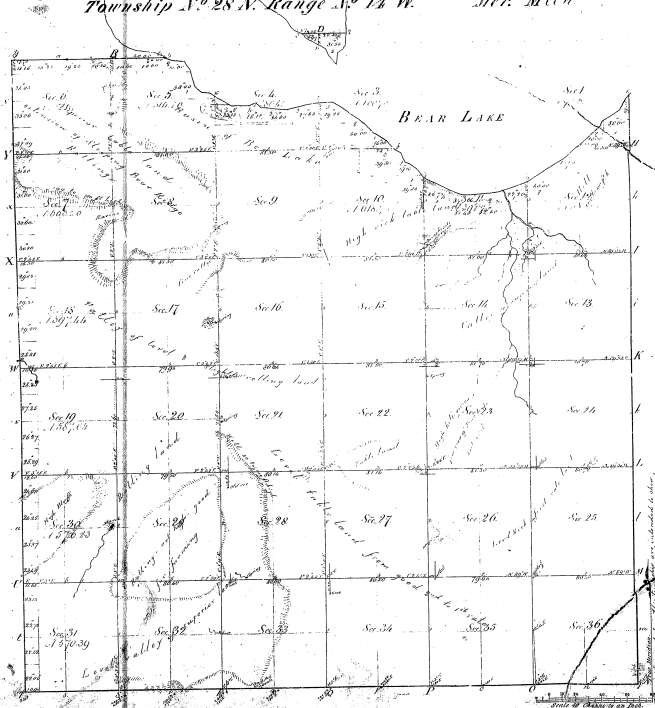




