Re-Survey of

Township N.o 28 N.- Range N.o 15 W. Mer. Mich

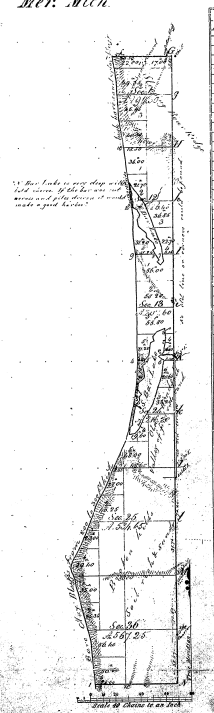

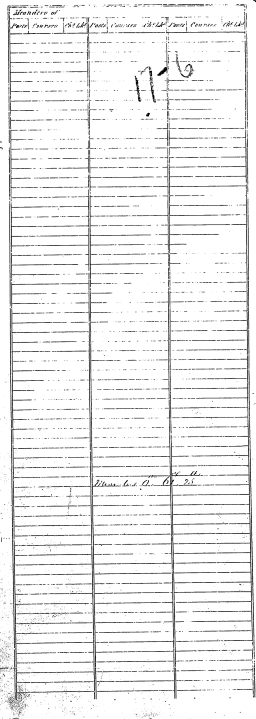

Total number of Acres 7 064.65

Surveys Designated.	By Whom Surveyed.	Date of Contract.	Amount of Surveys At $2.50 per	When Surveyed.	When Charged in the Genl Land Office
Re-Survey of Meanders			6 47 20	[illegible] 1855	
Subdivisions	George Kibbe	[illegible] 1857	19 25 80	[illegible] 1858	

The above Map of Township N.o 28 N. North of Range N.o 15 West of the Principal Meridian, Michigan, is strictly conformable to the field notes of the Survey thereof returned to and now on file in this Office.

Surveyor General's Office
Detroit, July 26 1858

Charles Mills Asst Gen.l

9-171