


Resurvey  
Township N<sup>o</sup> 29 N Range N<sup>o</sup> 12 W

Mer. Mech.

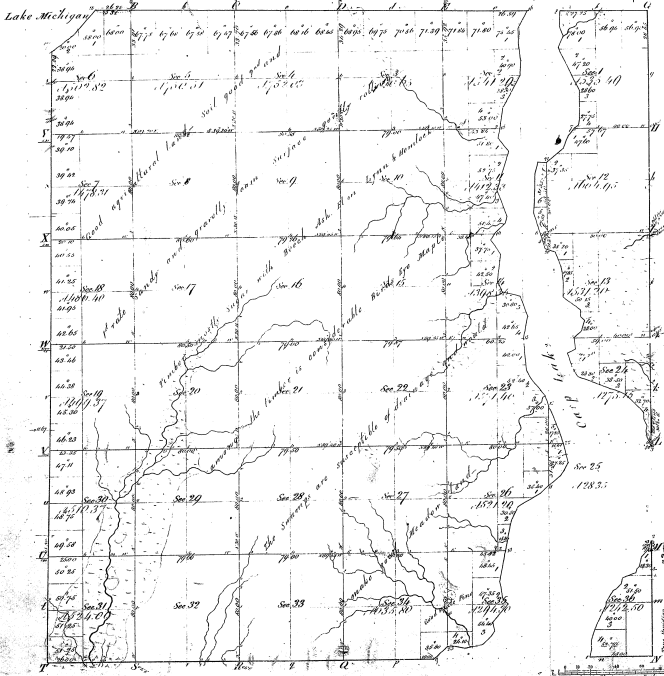








16-8