Resurvey

Township N° 31 N. Range N° 11 W. Mer. Mich.

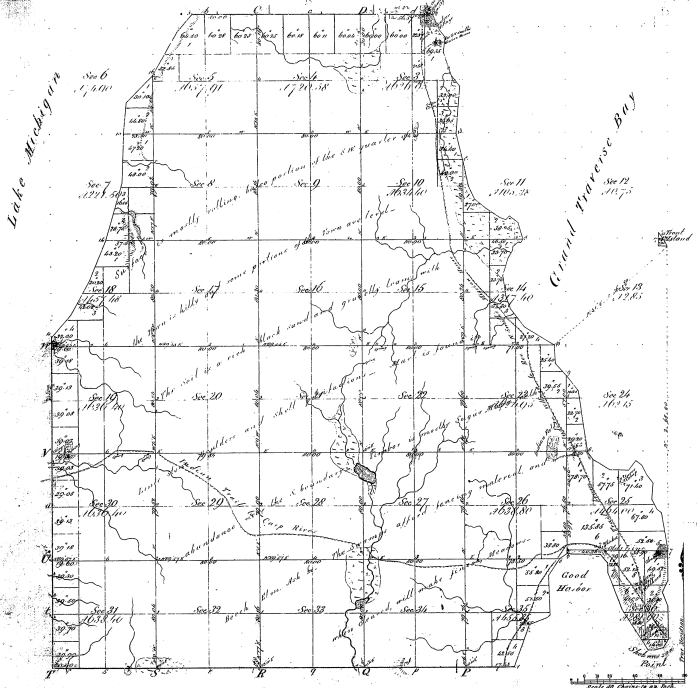

Boundaries of								
Town	Courses	Dist Lks	Town	Courses	Dist Lks	Town	Courses	Dist Lks

Re Survey (Supplemental Plat)

Township N.o 31 N. Rang.e N.o 11 W. Mer. Michigan

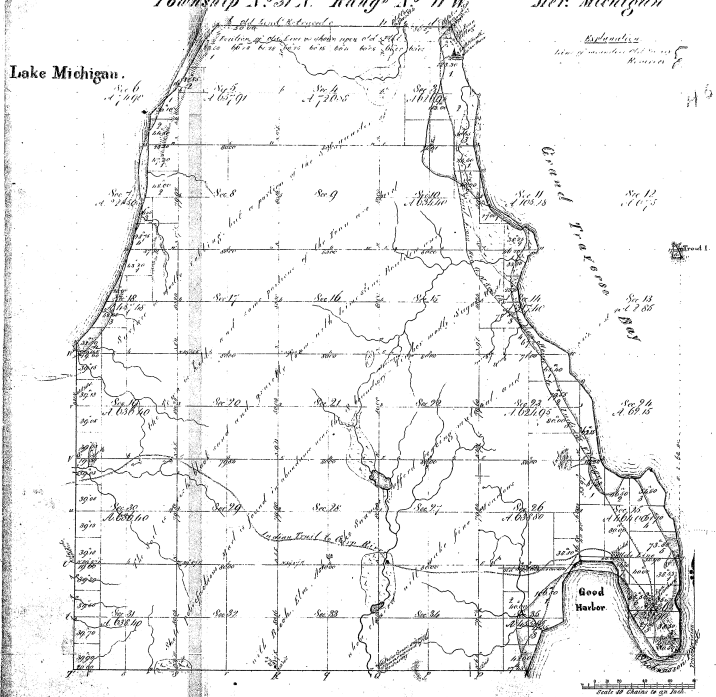

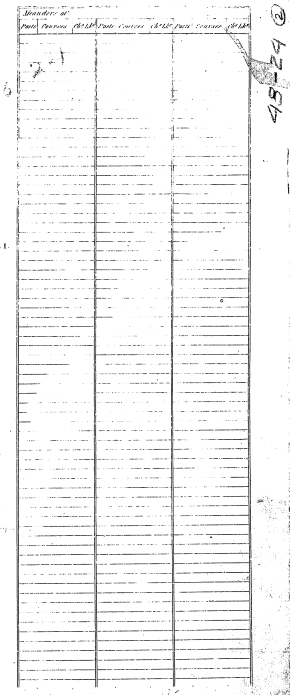

Surveys Dispatched.	By Whom Surveyed.	Date of Contract.	Amount of Surveys at Ch.	Amount of Surveys at Lks.	When Surveyed.	When Changed in the Gen.l Land Office
Township lines	A. D. Wadsworth, Deputy Surveyor	Nov.r 16	67	68	2.nd Quar. 1856	
Subdivisions	A. D. Wadsworth, Deputy Surveyor	Nov.r 16	67	68	2.nd Quar. 1856	

Total number of Acres 17218.85

The above Map of Township C.N.o 31 North of Range C.N.o 11 West of the Principal Meridian, Michigan, is strictly conformable to the field notes of the survey thereof on file in this Office, which have been examined and approved.

Surveyor Generals Office
Detroit Aug 24th 1858

Charles Noble
Asst Genl