

Township No. 31 N Range No. 15 W Mer. Mich.

Part of ^{N^W} S. Manitow Islands

Lake Michigan



Lake Michigan.



Part of S. Manitow Islands
Total Number of Acres 2,635.92

Average Endorsed.	By Whom Assented.	Date of Grant.	Amount of Range.	When Assented.	When Paid and Paid to the State or to the State.
Township Lines	C. R. Rader	April 22, 1847	4. 22. 52	24 of 1847	
Subdivisions	C. R. Rader	April 22, 1847	14. 54. 52	30 of 1847	

The above map of Township No. 31 North of Range No. 15 West of the Principal Meridian, Michigan, is strictly conformable to the field notes of the survey thereof on file in this office, which have been examined and approved.

Surveyor General's Office
Detroit, Mich. 16 1848

L. Lewis Logan
Surveyor General

M. C. L.
Manitow 6. 22. 56 of Section
1 65. 23 of Section
8 87. 107


4B-21
C. R. Rader
April 22, 1847

Township N^o 51 N Range N^o 15 W. Mer. Mich.

Part of S. Manitow Islands

LAKE MICHIGAN

LAKE MICHIGAN.

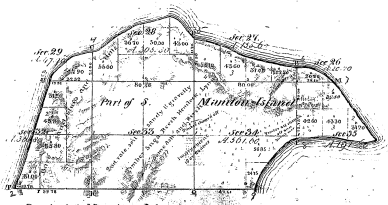

Part of S. Manitow Islands
Total number of acres 2635.07




Part of N. Manitow Islands

Section	Area	Remarks
1		
2		
48-2

The above map of Township N^o 51 N. Range N^o 15 W. West of the Principal Meridian, Michigan, was duly compared to the field notes of the survey thereof, on file in this Office, which have been examined and approved.
Surveyor General's Office
Detroit, Mich. 16 1858
L. C. Brown, Sur. Genl.