


Township N. V. South, Range N. II East Mer. (Mich. Ter.)

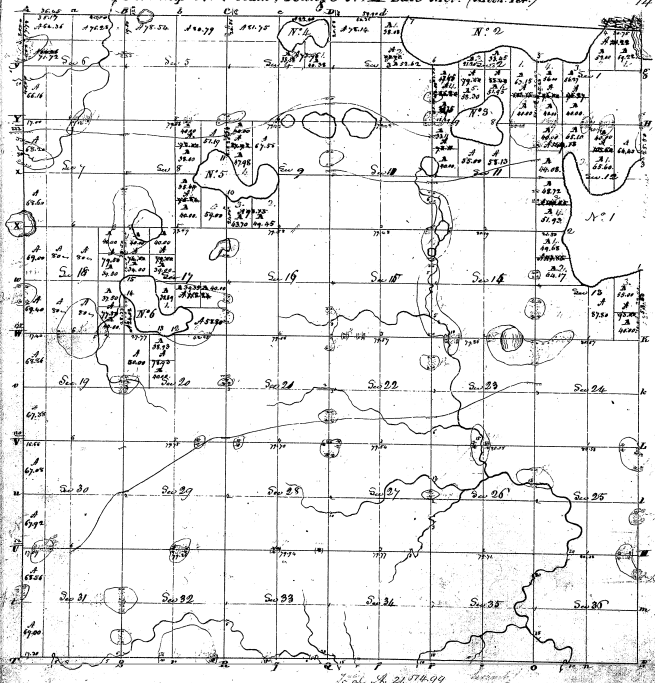

Pursuant to a contract with and instructions from Edward J. Coffin, Surveyor General, U. S. States, bearing date the day of ^{3/22} ~~3/22~~ I have administered laid out and surveyed the above described Township, and do certify that it hath been marked both exterior and interior as an official plat and described in the field notes, made thereof, and returned with this plat into the Surveyor General's Office. Witness this day of April 1922. Henry C. Cook, D. J.

81-05