


Township N<sup>o</sup> VIII south, Range N<sup>o</sup> III East Mer. (Mich. Ter.)

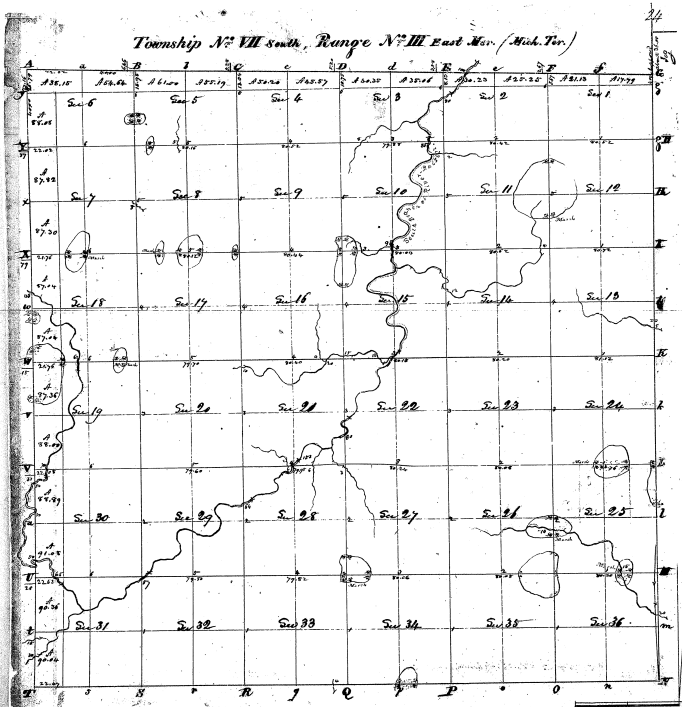

30-28

62-04

Total 36 31 633.57 Area 166.2  
166

1824

John Muller