


Township N. VII South, Range N. W. East of the Mer. (Mich. Ter.) 36

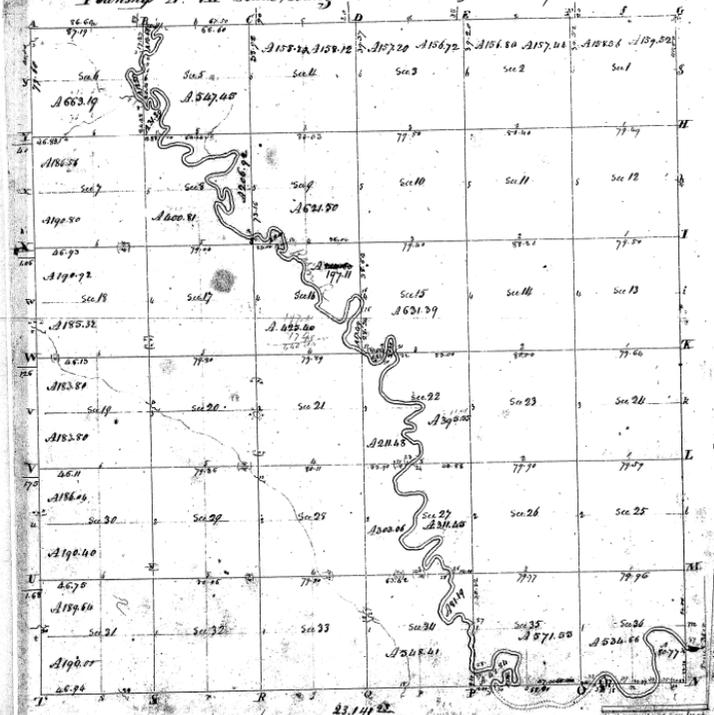

30-27

50-27



J. J. [Signature]