30-26

30-26

Township No. VII South, Range No. V East of Meridian. (Mich. Ter.)

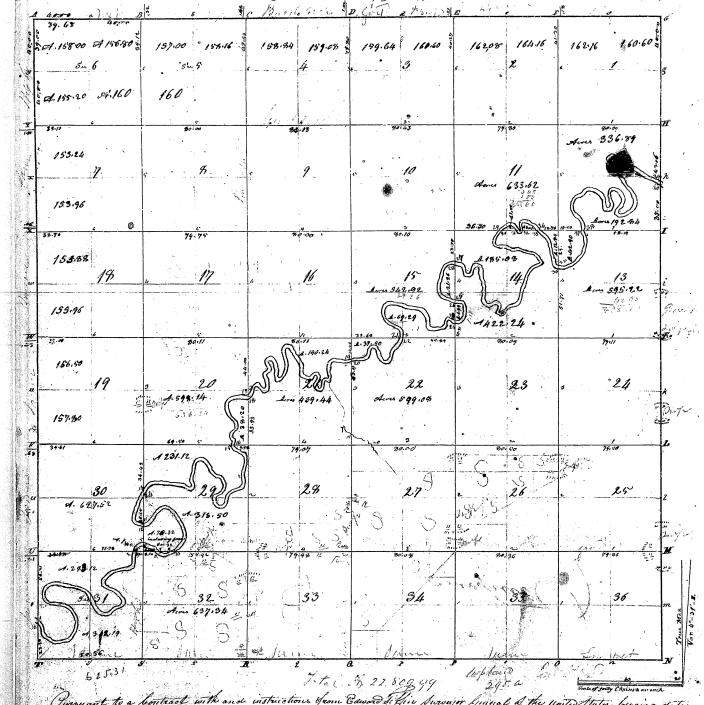

Pursuant to a Contract with and instructions from Edward Tiffin Surveyor General of the United States, bearing date the 20th day of April 1815. I have actually laid out and surveyed the above Township, and do hereby certify that the lines, both external and subdivisional as are represented on this plat and described in the field notes marked thereon, returned with this plat into this Surveyor Generals Office.

Attested this 25th day of April 1817.

Surveyor