


Township N. 18 South, Range N. 1 East Mer. (Mich. Ter.)

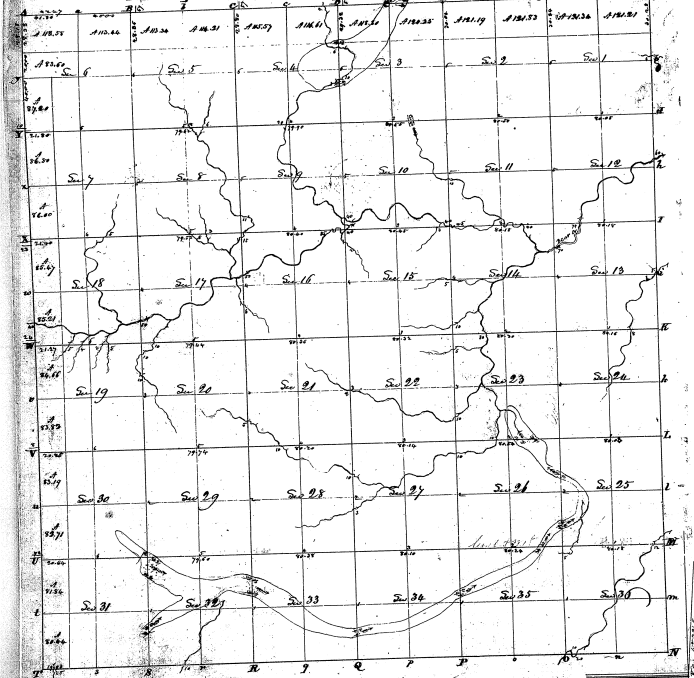

30-30

50-53


Surveyed by John

N. 18 S.

John Muller