


Township N. VIII South, Range N. IV East of Mer. (Mich. Ter.) 35

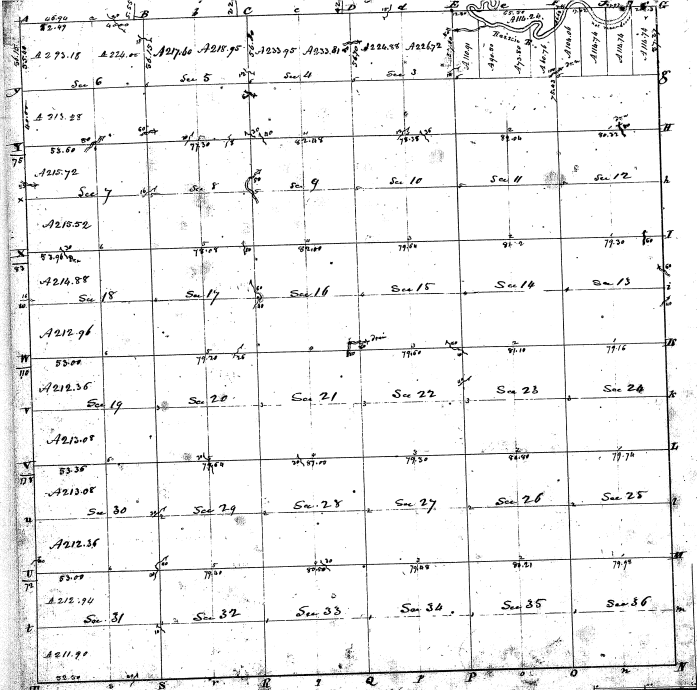

35
34

30-34



