


TAN RSE (Mich.)

24

27-27

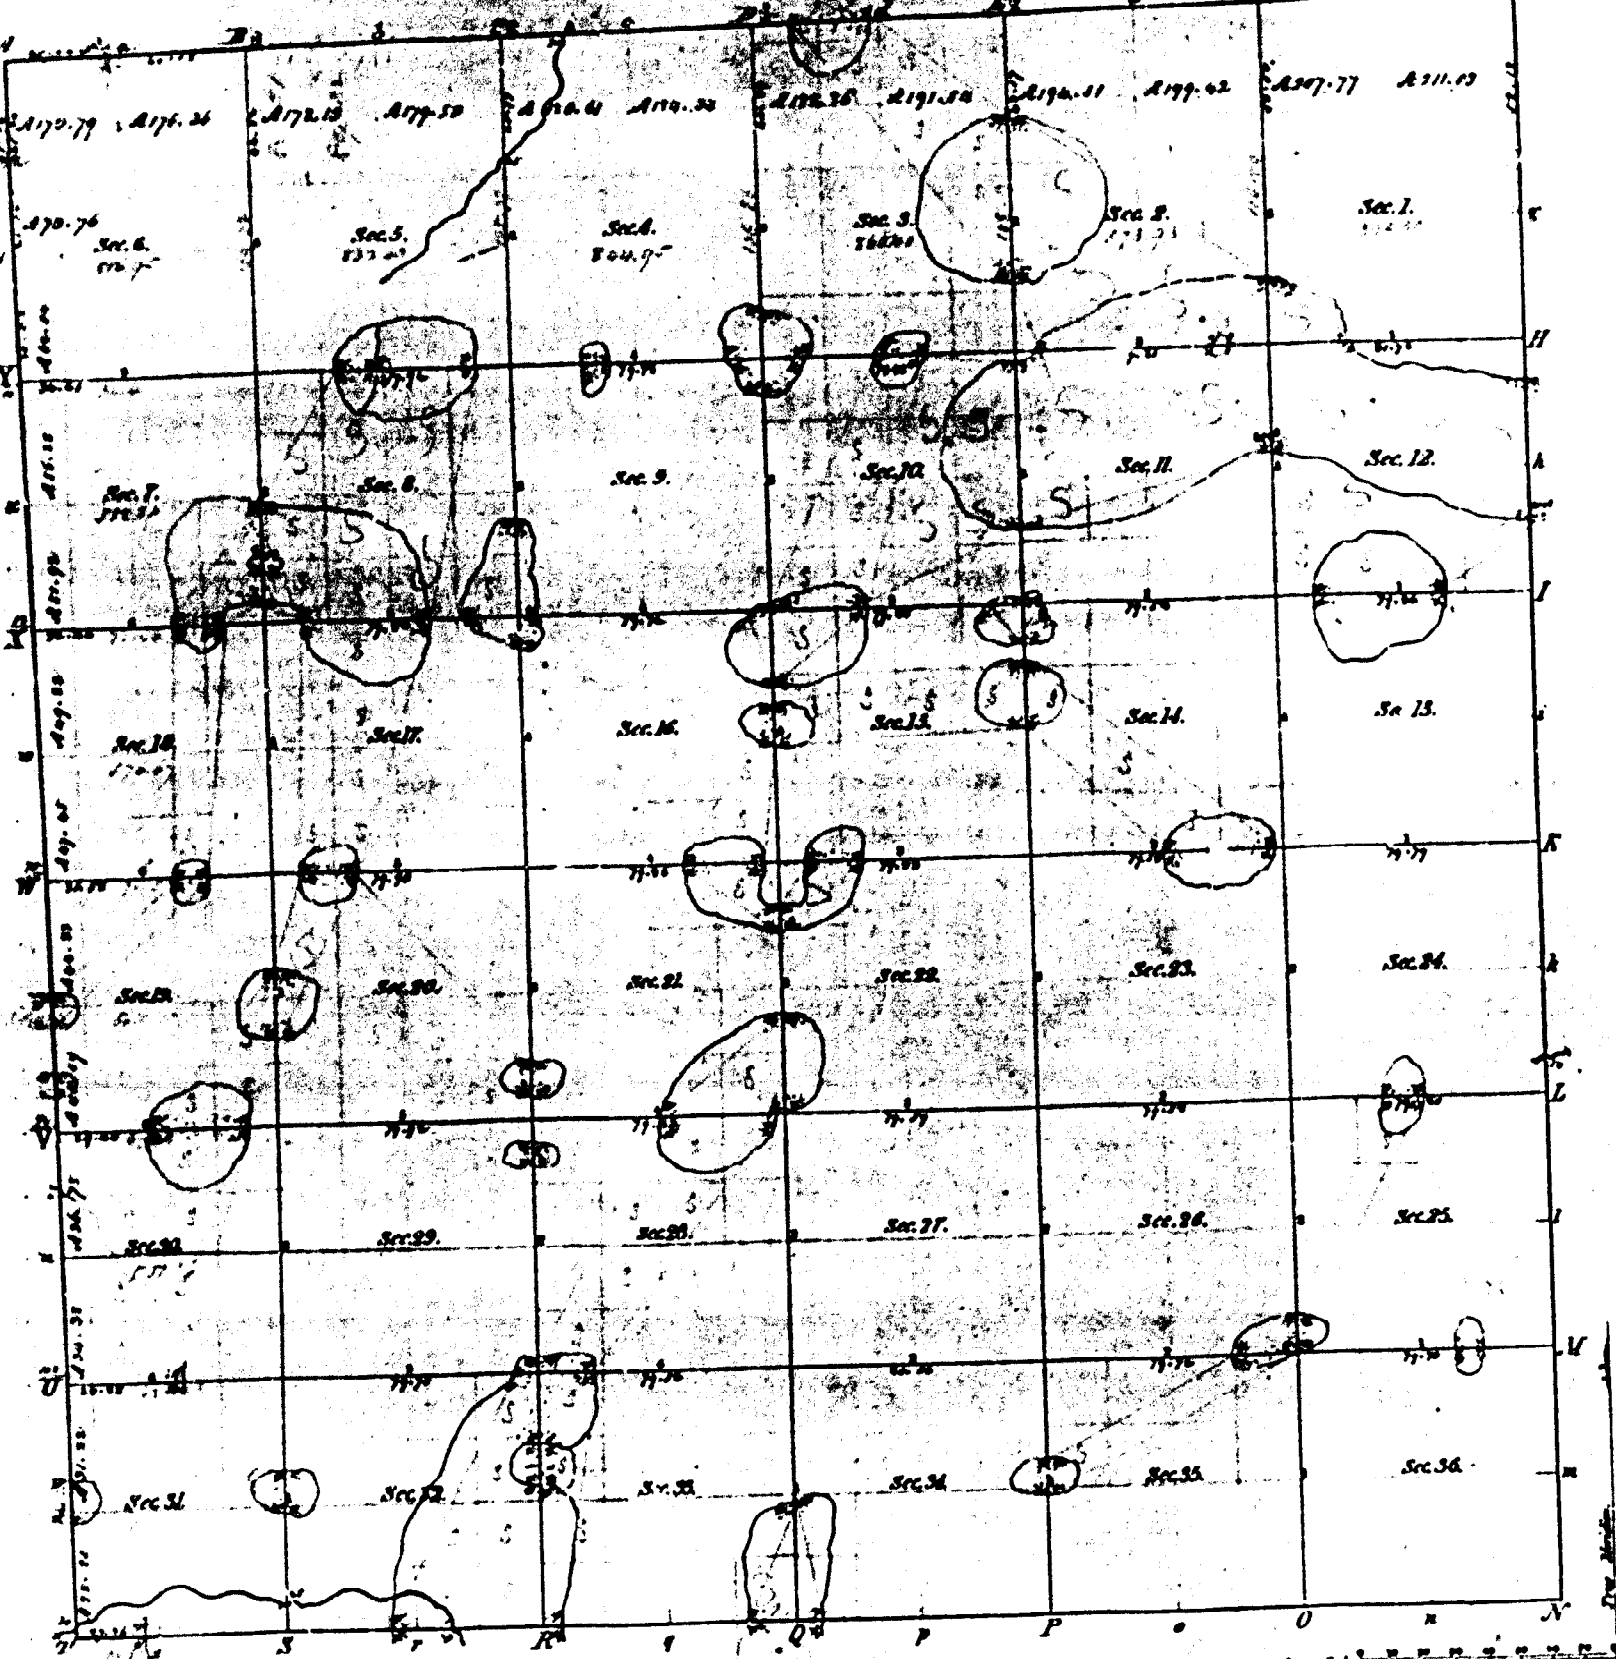

Surveyed in 1825 by Sylvester Sibley,

Deputy Surveyor.

I certify that the above is a true copy of the plot in this office.

Surveyor General's Office.
Cincinnati.

Sw: em!