Township No. 45 N. Range No. 11 W. — Mer. Mich.

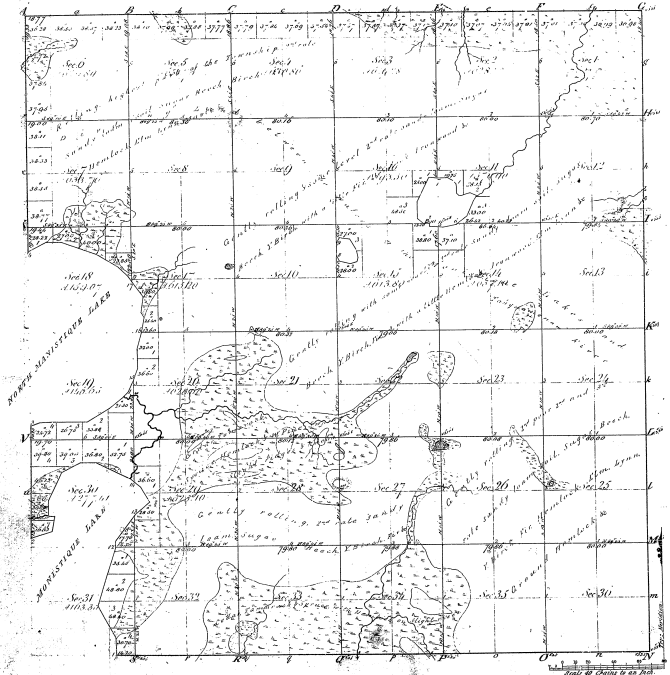

Meanders of
Past Current | Ch | Lks | Past Current | Ch | Lks | Past Current | Ch | Lks

Total Meanders
40 00 Chs
0 24 Lks

35-26

Total number of Acres 2803.77

Surveys Dangnated.	By Whom Surveyed.	Date of Contract.	Amount of Earnings $ Cts	When Surveyed.	When Charged to the Surveyor Gen'l.
Township lines.	W. J. Vanell	April 1st 1846	11 — 00	1846	
Subdivisions.	William Ives	June 7th 1849	55 20 16	1st Quarter 1849	

The above Map of Township No. 45 North of Range No. 11 West, of the Principal Meridian, Michigan, is strictly conformable to the field notes of the survey thereof on file in this Office, which have been examined and approved.

Surveyor General's Office
Detroit 1st January 1850

Wm. A. Fitch
Surv. Gen'l