


Township 47^N. Range 8^W. Mex. Mich.

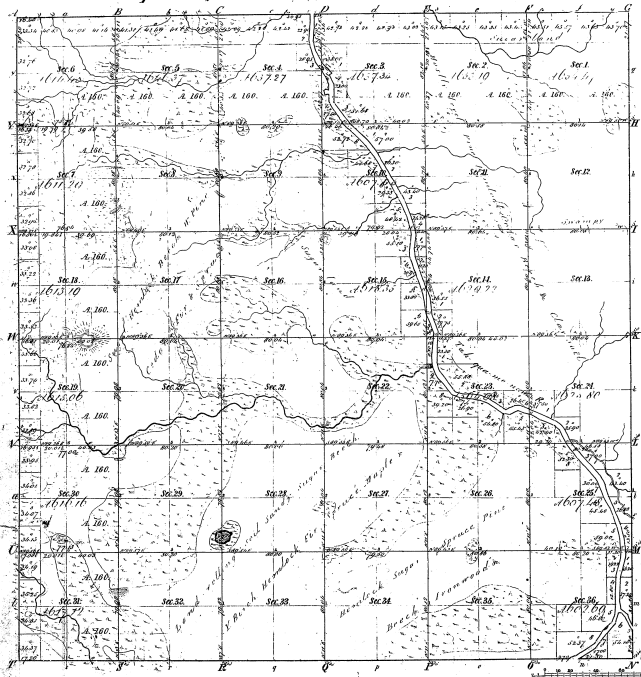

Boundaries of

35-17

35-17

Total number of Acres 29,914.2

Survey Designated	By Whom Surveyed	Date of Contract	Amount of Survey	When Surveyed	How Surveyed
Public Lands	Wells, Duval	April 26, 1850	29,914.2	1850	1 st Class

File above copy of Township 47 North, Range 8 West of the
 original of return on the survey as already performed to the field notes
 of the survey thereon on file in this office, and that these have been examined and approved.

Surveyor General's Office
 Detroit June 13, 1851

Charles A. Wells
 Surveyor

Total Area
 29,914.2
 66. 66. 14