Township N° 47 N. Range N° 9 W. Mer. Mich.

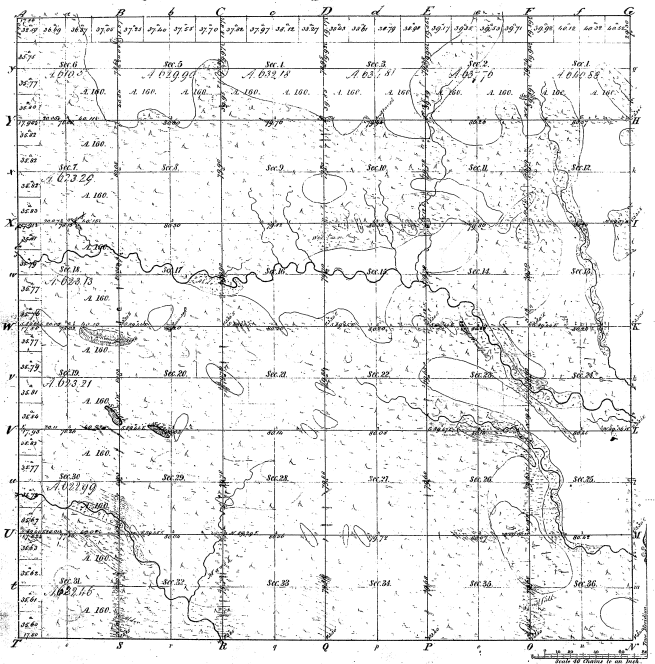

Meanders of

North Courses	W. Lk.	North Courses	W. Lk.	North Courses	W. Lk.

Total number of Acres 22 90/100

Survey Designated	By Whom Surveyed	Date of Contract	Amount of Surveys	When Surveyed	When 4th sec. and 28th m. due Gov't exec.

The above Map of Township N° 47 North of Range N° 9 West of the Principal Meridian Michigan is strictly conformable to the field notes of the survey thereof on file in this Office, which have been examined and approved.

Surveyor Generals Office
Detroit October 1, 1851

Surv. Genl.

81-83